

USDA-FOREST SERVICE


Index File No. J-19  
T 4S. R. 32E  
Merid. W.M.

CORNER RECORD (SEARCH)  
(Ref. FSM 7151.4)

Tract or Survey No. \_\_\_\_\_  
Cor. No. 1/4

R.D. Ukiah County Umatilla  
N.F. Umatilla State Oregon

CORNER DIAGRAM

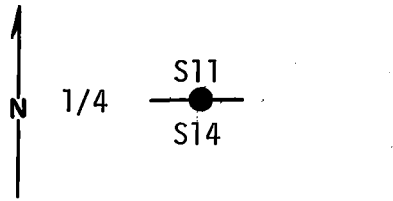

DESCRIBE CORNER MONUMENT FOUND  
Found 17"x15"x4" basalt stone clearly marked 1/4 on north face.

DESCRIBE BEARING TREES OR OTHER OFFICIAL ACCESSORIES FOUND  
No trace of bearing trees.

PHOTO IDENTIFICATION DATA

Photo No. \_\_\_\_\_  
Filed At. \_\_\_\_\_  
Object Ident. \_\_\_\_\_  
Ident. By \_\_\_\_\_  
*Signature*

DESCRIBE CORNER LOCATION RELATIVE TO NEAR-BY FEATURES, ALSO HOW TO REACH CORNER  
Corner is about 500' west of Fire Road and 300' south of a new fence.

PLANE COORDINATE POSITION DATA

State \_\_\_\_\_ Zone \_\_\_\_\_  
X \_\_\_\_\_  
Y \_\_\_\_\_  
Estab. By \_\_\_\_\_  
*Agency*

*Barry B. Barbour*

Title P.L.S. Division \_\_\_\_\_ Headquarters \_\_\_\_\_ Date 10/6/77  
7100-52-(3/68)

## CORNER RECORD (PERPETUATION)

MONUMENT: DESCRIBE NEW MONUMENT SET, OR WORK DONE TO PRESERVE EXISTING MONUMENT

T4S R32E

S11

1/4

S14

OR PLS 1051

1977

Set 2½" x 30" galvanized pipe with brass cap marked:

Set pipe 25" in the ground and placed corner stone at base of pipe. Mound around pipe.

9

ACCESSORIES : DESCRIBE NEW BT'S WITNESS OBJECTS ETC. ESTABLISHED, OR WORK DONE TO PRESERVE EXISTING EVIDENCE

A Fir 14" in dia. bears N30<sup>0</sup>W, 41.3 feet. Scribed 1/4 S11 BT. A Tamarac 16" in diameter bears S07<sup>0</sup>W, 20.7 feet scribed 1/4 S14 BT. Placed 54-3s & 54-4s on B.T.'s & brass washers stamped PLS 1051 on foot blazes. Painted 6" red bands around B.T.'s and both blazes red. Placed 54-4 on 6" Fir 4 feet west of corner.

10

Work Done By B.B. Barbour Title P.L.S. Date 10/6/77 State Registration No. OR PLS 1051  
or Agency

Certified Cor. Record Prepared? Yes  No  Filed At: \_\_\_\_\_ Date \_\_\_\_\_

11

## REMARKS

Witness to the above corner: D.L. Landers  
S. Nelson

12

Index File No.

T.

R.

M.

Tract or Surv. No.

Cor.

13