

# RECORD OF LAND CORNER MONUMENTATION

WEST QUARTER CORNER OF SECTION 17, T. 4 S., R. 32 E., W.M.


**ORIGINALLY ESTABLISHED BY:** George S. Pershin, U.S. Deputy Surveyor

**CONTRACT NUMBER:** 390

**CONTRACT DATE:** May 12, 1881

**SUBSEQUENT SURVEYS:**

- ▶ Survey by Barry B. Barbour, PLS 1051, filed as Survey No. O-67-A, performed during October - December, 1977.

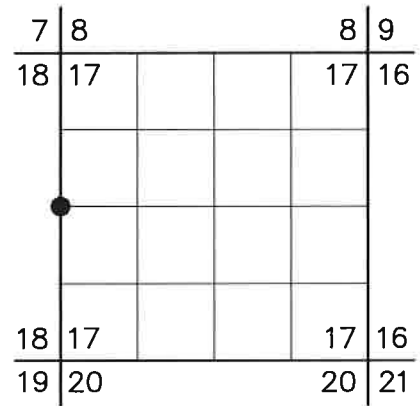

**ORIGINAL DESCRIPTION:**

Set basalt stone 14x 10x10 on south slope for ¼sec. cor.

A Pine 28 in. di. brs. S.70°E. 28 lks. dist.

A Pine 12 in. di. brs. N.63°W. 150 lks. dist.

**BARBOUR'S DESCRIPTION:**

Found loose 10"x10"x9" basalt stone clearly marked 1/4.

BLM tag on fence post marking approximate corner position.

Found 28" Pine stump with foot of blaze 6" from center of stump, but no visible scribing. BLM BT tag nailed on stump. No trace of SE BT could be found.

Corner is on the west side of a north-south fence and about 700' south of a private road bearing northwest into a canyon.

From Pine stump measured S63°E, 99.0' and set 2½" x 30" galvanized pipe with brass cap marked (diagram shown): Pipe is set 15" in the ground to bedrock and mound of stone to cap. Placed marked stone at base of pipe.

A Pine 12" dia. bears N41°E, 18.0', scribed 1/4 S17 BT.

A Pine 12" dia. bears S46°W, 22.6', scribed 1/4 S18 BT.

Placed 54-3s and 54-4s on trees, brass washer on BT blaze, marked PLS 1051.

Painted 6" red bands and both blazes red.

Placed 54-4 on existing fence post 3' south.

**EVIDENCE FOUND:**

Found a 2½" galvanized iron pipe with attached 2½" brass cap, marked as shown on the diagram, projecting 14" above ground in loose mound of stone with 2 ft. base. A fence line extending north and south, is 2 ft. east. Metal fence post with USFS 54-4 sign attached, due east, wired within fence line.

From which Barbour's bearing trees:

- ▶ A ponderosa pine, 13" dbh, bears N.41°E., 18.0 ft., with partially healed blaze & visible scribing in good condition.
- ▶ A ponderosa pine, 15" dbh, bears S.46°W., 27.0 ft., (22.6 ft. Record) with partially healed blaze & visible scribing in good condition. Note: Barbour's found bearing tree tag shows a recorded distance of 27 ft.


**DESCRIPTION OF MONUMENTS AND ACCESSORIES SET AND METHODS USED:**

I accept the position of the found monument, and rebuild the mound of stone, with a 3 ft. base and 11" tall.

From which, **I SET NEW REFERENCE MONUMENTS:**

- ▶ A 5/8" x 24" iron rod, bears S.46°W., 8.30 ft., with attached 2" aluminum cap marked *RM 1 2024 PLS 91693.*
- ▶ A 5/8" x 24" iron rod, bears N.44°W., 9.04 ft., with attached 2" aluminum cap marked *RM 2 2024 PLS 91693.*

**CORNER MONUMENT MARKED:**

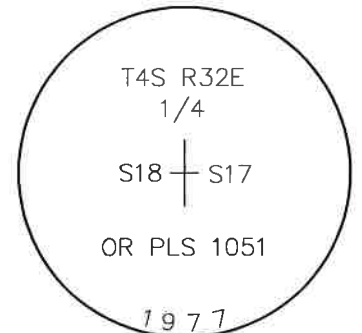

Attached USFS 54-9 signs to bearing trees and guard post as needed. Distances measured with steel tape. Bearings measured with a handheld compass with 14° east declination. Iron rods were driven to refusal.

# RECORD OF LAND CORNER MONUMENTATION

WEST QUARTER CORNER OF SECTION 17, T. 4 S., R. 32 E., W.M.

## RESTORATION BY, STAMP AND DATE:

Work performed June 27, by:

T. DeJesus Quinones, LSIT  
Vincent L. Kelly  
Spencer B. Jones

USDA FOREST SERVICE  
NORTHEAST OREGON LAND ZONE  
1550 Dewey Avenue, Suite A  
Baker City, OR 97814  
(541) 523-1281



RENEWS: 12/31/2024

24-077-6