

USDA-FOREST SERVICE


Index
 File No. L-8
 T 4S R. 32E
 Merid. W.M.

CORNER RECORD (SEARCH)

(Ref. FSM 7151.4)

Tract or
 Survey No. _____
 Cor. No. CE1/16
 R.D. Ukaih County Umatilla
 N.F. Umatilla State Oregon

CORNER DIAGRAM

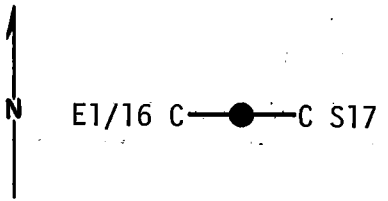

DESCRIBE CORNER MONUMENT FOUND

None set.

DESCRIBE BEARING TREES OR OTHER OFFICIAL ACCESSORIES FOUND

None set.

PHOTO IDENTIFICATION DATA

Photo No. _____
 Filed At. _____
 Object Ident. _____
 Ident. By _____
Signature

DESCRIBE CORNER LOCATION RELATIVE TO NEAR-BY FEATURES, ALSO HOW TO REACH CORNER

Corner falls on the west end of small open bench.

PLANE COORDINATE POSITION DATA

State _____ Zone _____
 X _____
 Y _____
 Estab. By _____
Agency

Beverly B. Barbour
 Signature

Title P.L.S. Division _____ Headquarters _____ Date 11/3/77
 7100-52-(3/68)

CORNER RECORD (PERPETUATION)

GPO 902-673

MONUMENT: DESCRIBE NEW MONUMENT SET, OR WORK DONE TO PRESERVE EXISTING MONUMENT

Set 2½"x30" galvanized pipe with brass cap marked:
Set 16" in the ground with mound of stone around.

T4S R32E
E1/16 C ——— C S17
OR PLS 1051
1977

9

ACCESSORIES: DESCRIBE NEW BT'S WITNESS OBJECTS ETC. ESTABLISHED, OR WORK DONE TO PRESERVE EXISTING EVIDENCE

A pine 15" in dia. bears S57⁰W, 21.6 ft., scribed E1/16 S17 BT. A pine 12" in dia. bears S78⁰E, 20.7 ft., scribed E1/16 S17 BT. Placed 54-3 and 54-4 on BT's and brass washers stamped PLS 1051 on BT blazes. Painted blazes red and 6" red band around BT's. Placed 54-2 and 54-9 on fence posts 4' south. Placed 54-2 and 54-4 on fence post 5' east of corner.

10

Work Done By B.B. Barbour Title P.L.S. Date 11/3/77 State Registration No. OR PLS
or Agency

Certified Cor. Record Prepared? Yes No Filed At: _____ Date _____

11

REMARKS

Witnesses to the above: D.L. Landers, S. Nelson

12

Index File No. _____ T. _____ R. _____ M. _____ Tract or Surv. No. _____ Cor. _____

13