

USDA-FOREST SERVICE

Index  
 File No. L-9  
 T 4S R. 32E  
 Merid. W.M.


CORNER RECORD (SEARCH)

(Ref. FSM 7151.4)

Tract or  
 Survey No. \_\_\_\_\_ Cor. 1/4  
 No. \_\_\_\_\_

R.D. Ukiah County Umatilla  
 N.F. Umatilla State Oregon

CORNER DIAGRAM

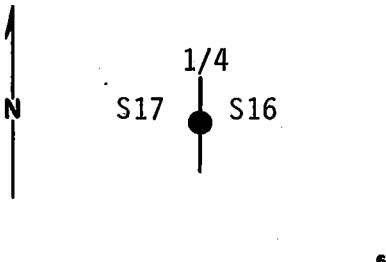

DESCRIBE CORNER MONUMENT FOUND

No monument found.

DESCRIBE BEARING TREES OR OTHER OFFICIAL ACCESSORIES FOUND

Found bent 12" pine with partially opened blaze and some lettering visible. 54-3 on tree. Found old Forest Service Location Tag on tree near approximate corner position.

PHOTO IDENTIFICATION DATA

Photo No. \_\_\_\_\_  
 Filed At. \_\_\_\_\_  
 Object Ident. \_\_\_\_\_  
 Ident. By \_\_\_\_\_  
*Signature*

DESCRIBE CORNER LOCATION RELATIVE TO NEAR-BY FEATURES, ALSO HOW TO REACH CORNER

Corner falls East of a North-South fence about 500 ' West of a private road.

PLANE COORDINATE POSITION DATA

State \_\_\_\_\_ Zone \_\_\_\_\_  
 X \_\_\_\_\_  
 Y \_\_\_\_\_  
 Estab. By \_\_\_\_\_  
*Agency*

*Barney B. Barbour*

Title P.L.S. Division \_\_\_\_\_ Headquarters \_\_\_\_\_ Date 10/21/77  
 7100-52-(3/68)

CORNER RECORD (PERPETUATION)

MONUMENT: DESCRIBE NEW MONUMENT SET, OR WORK DONE TO PRESERVE EXISTING MONUMENT

From the base of the B.T., measured East 64.7' and set 2 1/2" x 30" galvanized pipe with brass cap marked:  
Set pipe 14" in the ground to bedrock and mound of stone to cap.

T4S R32E  
1/4  
S17 + S16  
OR PLS 1051  
1977

ACCESSORIES: DESCRIBE NEW BT'S WITNESS OBJECTS ETC. ESTABLISHED, OR WORK DONE TO PRESERVE EXISTING EVIDENCE

A pine 17" in dia. bears S83°E, 116.8' scribed 1/4 S16 BT. Placed brass washer stamped PLS 1051 on BT blaze. Placed 54-3, 54-4s on BT's. Placed 54-2 and 54-4 on fence post 5' west of corner. Placed 54-2 on fence post 3' south of corner. Painted blazes red and 6" red band on new BT.

Work Done By B.B. Barbour Title P.L.S. Date 10/21/77 State Registration No. OR PLS 1051  
or Agency

Certified Cor. Record Prepared? Yes  No  Filed At: \_\_\_\_\_ Date \_\_\_\_\_

REMARKS

Witness to the above corner: D.L. Landers  
S. Nelson