

Index  
File No. P-17

**CORNER RECORD (SEARCH)**

(Ref. FSM 7151.4)

Tract or Survey No. \_\_\_\_\_ Cor. No. \_\_\_\_\_


T 4 S R: 32 E

R.D. Ukiah County Umatilla

Merid. Willamette

N.F. Umatilla State Oregon

**CORNER DIAGRAM**

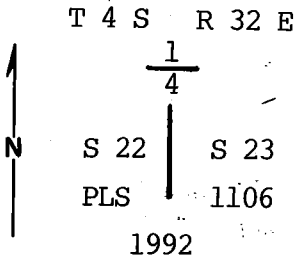

**DESCRIBE CORNER MONUMENT FOUND**

Found basalt stone 24 x 19 x 6" lying on it's side with no marks evident.

**DESCRIBE BEARING TREES OR OTHER OFFICIAL ACCESSORIES FOUND**

A 29" douglas fir snag brs N77 3/4° W, 32.9' with mostly healed blaze with no scribing visible.  
A 37" douglas fir snag brs East, 38.4' with scribing visible.

Note: The above bearing trees appear to be original but there is no original record for them.

**DESCRIBE CORNER LOCATION RELATIVE TO NEAR-BY FEATURES, ALSO HOW TO REACH CORNER**

Corner falls on Southerly slope about 4' North of fence. corner, fences S & W.

**PHOTO IDENTIFICATION DATA**

Photo No. \_\_\_\_\_  
Filed At. \_\_\_\_\_  
Object Ident. \_\_\_\_\_  
Ident. By \_\_\_\_\_  
*Signature*

**PLANE COORDINATE POSITION DATA**

State \_\_\_\_\_ Zone \_\_\_\_\_  
X \_\_\_\_\_  
Y \_\_\_\_\_  
Estab. By \_\_\_\_\_  
*Agency*

*Signature*  
Walter R. Wells

*Title*  
Land Surveyor

*Division*

*Headquarters*  
Pendleton, Ore.

*Date*  
6-09-92

FS-7100-52 (3/68)

**CORNER RECORD (PERPETUATION)**

**MONUMENT: DESCRIBE NEW MONUMENT SET, OR WORK DONE TO PRESERVE EXISTING MONUMENT**

At the position of the found stone...

Set a 2½" X 30" aluminum pipe with 2½" aluminum cap 22" in ground surrounded with mound of earth and stone. Set steel fence post next to corner and attached signs 54-2 & 54-9. Cap marked as shown in corner diagram. Set original stone alongside of new monument in mound. Compass declination 18° East.

9

**ACCESSORIES : DESCRIBE NEW BT'S WITNESS OBJECTS ETC. ESTABLISHED, OR WORK DONE TO PRESERVE EXISTING EVIDENCE**

New bearing trees established:

A 11" ponderosa pine brs S67° E, 36.4' mkd 1/4S23 BT.

A 7" ponderosa pine brs S76¼° E, 74.5' mkd 1/4S23 BT.

A 12" ponderosa pine brs N7¼° W, 65.9' mkd 1/4S22 BT.

A 12" ponderosa pine brs S73½° W, 51.0' mkd 1/4S22 BT.

New BT's have a brass washer stamped PLS 1106 nailed to face of blaze.

Attached sign 54-3 & 54-9, painted face of blaze & a 6" red band around each BT.

10

Work Done By W.R. Wells Title Land Surveyor Date 6-09-92 State Registration No. ORLS 1106  
or Agency

Certified Cor. Record Prepared ? Yes  Filed At Umatilla County Surveyor Date 7-92

11

**REMARKS**

Index File No. P-17 T. 4 S. R. 32 E. M Tract or Surv. No. Cor. 13


Index File No. P-17  
 T 4 S R. 32 E  
 Merid. Willamette

**CORNER RECORD (SEARCH)**  
 (Ref. FSM 7151.4)

Tract or Survey No. 108-75 Cor. No. P-17

R.D. Ukiah County Umatilla  
 N.F. Umatilla State Oregon

**CORNER DIAGRAM**

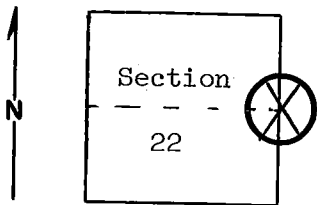

**DESCRIBE CORNER MONUMENT FOUND**

Material: Basalt Stone. Size: 24" x 16" x 4"  
 2" above ground; no markings visible.

**DESCRIBE BEARING TREES OR OTHER OFFICIAL ACCESSORIES FOUND**

No accessories mentioned in G.L.O. notes.  
 38" fir bears N 88° E approximately 40' from stone. Tree is blazed on west face and scribed 1/4 S. Forest Service metal location poster on tree with initials FGW. No date. I placed B.T. tag on tree although no tree mentioned in notes.  
 30" fir bears N 82° W approximately 35' from stone. Tree is (cont. in block 12)

**DESCRIBE CORNER LOCATION RELATIVE TO NEAR-BY FEATURES, ALSO HOW TO REACH CORNER**

Stone is 3' north of fence corner on south shoulder of primitive road. Fence south and west.

**PHOTO IDENTIFICATION DATA**

Photo No. \_\_\_\_\_  
 Filed At. \_\_\_\_\_  
 Object Ident. \_\_\_\_\_  
 Ident. By \_\_\_\_\_  
*Signature*

**PLANE COORDINATE POSITION DATA**

State \_\_\_\_\_ Zone \_\_\_\_\_  
 X \_\_\_\_\_  
 Y \_\_\_\_\_  
 Estab. By \_\_\_\_\_  
*Agency*

Signature B. Moore Title Engineering Technician Division \_\_\_\_\_ Headquarters S. O. Date March 1975 7100-52-(3/68)

CORNER RECORD (PERPETUATION)

MONUMENT: DESCRIBE NEW MONUMENT SET, OR WORK DONE TO PRESERVE EXISTING MONUMENT

9

ACCESSORIES : DESCRIBE NEW BT'S WITNESS OBJECTS ETC. ESTABLISHED, OR WORK DONE TO PRESERVE EXISTING EVIDENCE

10

Work Done By \_\_\_\_\_ Title \_\_\_\_\_ Date \_\_\_\_\_ State Registration No. or Agency \_\_\_\_\_  
Certified Cor. Record Prepared ? Yes No Filed At: \_\_\_\_\_ Date \_\_\_\_\_

11

(cont. from block 3)

REMARKS

blazed on east face with Forest Service location poster on it, dated 8/13/40, VIM RVC.

12

Index File No. / T. R. M. Tract or Surv. No. Cor. 13