


Index
 File No. P-9
 T 4 S R. 32 E
 Merid. Willamette

CORNER RECORD (SEARCH)

(Ref. FSM 7151.4)

R.D. Ukiah County Umatilla Tract or Survey No. _____ Cor. No. _____
 N.F. Umatilla State Oregon

CORNER DIAGRAM

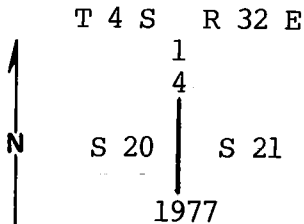

DESCRIBE CORNER MONUMENT FOUND

Found 2½" iron pipe with ¾" brass cap (as shown in corner diagram) in mound of stone.

DESCRIBE BEARING TREES OR OTHER OFFICIAL ACCESSORIES FOUND

- A 32" douglas fir brs S10°W, 45.8' dist with scribing visible.
- A 18" douglas fir " brs S17½°E, 78.0' dist with scribing visible.
- A 32" douglas fir brs S25½°E, 35.9' dist with healed blaze.

PHOTO IDENTIFICATION DATA

Photo No. _____
 Filed At. _____
 Object Ident. _____
 Ident. By _____
 Signature _____

DESCRIBE CORNER LOCATION RELATIVE TO NEAR-BY FEATURES, ALSO HOW TO REACH CORNER

Corner falls on Southwesterly slope. BT's visible from road to South, posted line North.

PLANE COORDINATE POSITION DATA

State _____ Zone _____
 X _____
 Y _____
 Estab. By _____
 Agency _____

Signature
Willis R. Webb

Title Land Surveyor Division _____ Headquarters Pendleton, Ore.

Date 6-02-92

CORNER RECORD (PERPETUATION)

MONUMENT: DESCRIBE NEW MONUMENT SET, OR WORK DONE TO PRESERVE EXISTING MONUMENT

Set steel fence post next to corner with sign 54-9 & 54-2 attached.
Compass declination 18° East.

9

ACCESSORIES : DESCRIBE NEW BT'S WITNESS OBJECTS ETC. ESTABLISHED, OR WORK DONE TO PRESERVE EXISTING EVIDENCE

New bearing tree established:

A 13" ponderosa pine brs N53°E, 56.8' dist. scribed 1/4S21 BT.

New BT's have a brass washer stamped PLS 1106 nailed to face of blaze.

Attached sign 54-3 & 54-9, painted face of blaze & a 6" red band around each BT.

10

Work Done By W.R. Wells Title Land Surveyor Date 6-02-92 State Registration No. ORLS 1106
or Agency

Certified Cor. Record Prepared ? Yes Filed At: Umatilla County Surveyor Date 7-92

11

REMARKS

12

Index File No. p-9 T. 4 S. R. 32 E. M. Tract or Surv. No. Cor. 13