

Index  
File No. Q-15

**CORNER RECORD (SEARCH)**

(Ref. FSM 7151.4)

Tract or  
Survey No. \_\_\_\_\_ Cor.  
No. \_\_\_\_\_


T 4 S R. 32 E

R.D. Ukiah County Umatilla

Merid. Willamette

N.F. Umatilla State Oregon

**CORNER DIAGRAM**

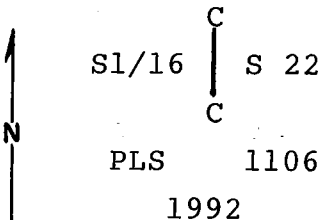

**DESCRIBE CORNER MONUMENT FOUND**

None. Corner established as part of this survey.

**DESCRIBE BEARING TREES OR OTHER OFFICIAL ACCESSORIES FOUND**

None.

**PHOTO IDENTIFICATION DATA**

Photo No. \_\_\_\_\_  
Filed At. \_\_\_\_\_  
Object Ident. \_\_\_\_\_  
Ident. By \_\_\_\_\_

*Signature*

**PLANE COORDINATE POSITION DATA**

State \_\_\_\_\_ Zone \_\_\_\_\_  
X \_\_\_\_\_  
Y \_\_\_\_\_  
Estab. By \_\_\_\_\_

*Agency*

**DESCRIBE CORNER LOCATION RELATIVE TO NEAR-BY FEATURES, ALSO HOW TO REACH CORNER**

Corner falls on southerly slope, N of road. BT's visible from road. Posted line E & W.

*Signature*

*Walter R. Wells*

*Title*

Land Surveyor

*Division*

Headquarters

Pendleton, Ore.

*Date*

6-10-92

FS-7100-52 (3/68)

**CORNER RECORD (PERPETUATION)**

**MONUMENT: DESCRIBE NEW MONUMENT SET, OR WORK DONE TO PRESERVE EXISTING MONUMENT**

At position established by survey...

Set a 2½" X 30" aluminum pipe with 2½" aluminum cap 20" in ground surrounded with mound of earth and stone set steel fence post next to corner and attached signs 54-2 & 54-9. Cap marked as shown in corner diagram.

Compass declination 18° East.

9

**ACCESSORIES : DESCRIBE NEW BT'S WITNESS OBJECTS ETC. ESTABLISHED, OR WORK DONE TO PRESERVE EXISTING EVIDENCE**

New bearing trees established:

A 19" ponderosa pine brs N2 W, 14.4' scribed CS1/16S22 BT.

A 11" ponderosa pine brs N78¼ W, 66.4' scribed CS1/16S22 BT.

New BT's have a brass washer stamped PLS 1106 nailed to face of blaze.

Attached sign 54-3 & 54-9, painted face of blaze & a 6" red band around each BT.

10

Work Done By W.R. Wells Title Land Surveyor Date 6-10-92 State Registration No. ORLS 1106  
or Agency

Certified Cor. Record Prepared ? Yes XXX Filed At Umatilla County Surveyor Date 7-92 11

**REMARKS**

12

Index File No. Q-15 T. 4 S R. 32 E WM Tract or Surv. No. Cor. 13