

USDA FOREST SERVICE

CORNER RECORD (SEARCH)

Index

File No. V-22

R.D.: N.F.J.D.

Co. Survey No:

T.4S., R.32E.

N.F.: UMATILLA

County: Umatilla

Meridian: Willamette

CORNER DIAGRAM

DESCRIBE CORNER MONUMENT FOUND

T4S R32E

S25

None. Corner established this survey.

W1/16

S36

1994

PLS 2405

DESCRIBE BEARING TREES OR OTHER OFFICIAL ACCESSORIES FOUND

None. Corner established this survey.

PHOTO ID DATA

Photo No.

Filed At

Object ID

PLANE CO-ORD

State Zone

X

Y


Estab. By

DESCRIBE CORNER LOCATION:

Corner falls on top of east edge of P.Pine on ridge.

Ridgetop runs S30°E. Old road is 75 ft. west.

Signature:

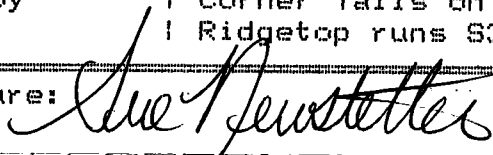

Title: Land Surveyor

Date: 10/26/94

CORNER RECORD (PERPETUATION)

MONUMENT: DESCRIBE NEW MONUMENT SET, OR WORK DONE TO PRESERVE EXISTING MON.
Set 2-1/2"x30" aluminum pipe with 3-1/2" aluminum cap, stamped as shown
on the DIAGRAM, 6" in the ground and raised a mound of stone, 4 ft. dia. x
2 ft. high around the monument. From Which:

ACCESSORIES: DESCRIBE NEW BT'S, W.O.'S ETC. ESTABL./WORK DONE TO PRESERVE
Ponderosa Pine, 10" dia., bears N31°40'W, 36.6 ft., scribed: W1/16 S25 BT
Ponderosa Pine, 14" dia., bears S47°01'E, 40.7 ft., scribed: W1/16 S36 BT
Measurements to BT's taken with an Electronic Tacheometer with bearings
based on the survey control network. Set steel fence post with Land Survey
Monument (54-9) and Property Boundary (54-2) signs 5' north and west of the
monument. Nailed a brass washer stamped PLS 2405 on blaze above BT scribe
as taken this survey. Nailed Bearing Tree (54-3) signs above blaze and
Land Survey Monument (54-9) signs on back of each tree as required.
Painted a 6" red band above Bearing Trees signs.

Work Done by: Susan E. Newstetter Dr. Land Surveyor No. 2405 Date: 10/26/94
Certified Cor. Record Prepared? Yes No Filed At: Umatilla Co. Survey.

REMARKS

Index File No. V-22

T.4S., R.32E., W.M.