

Index
File No. 7-23


CORNER RECORD (SEARCH)
(Ref. FSM 7151.4)

Tract or
Survey No. _____ Cor. No. 2375

T 35 R. 33E R.D. LAGRANDE County UNION & WASHINGTON

Merid. WILLAMETTE N.F. WALLOWA-WHITE State OREGON

CORNER DIAGRAM

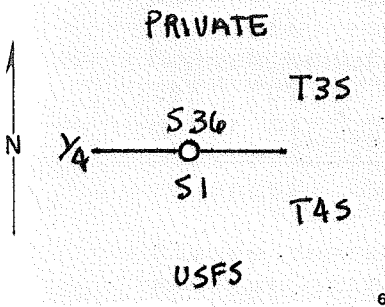

DESCRIBE CORNER MONUMENT FOUND

NDNE

DESCRIBE BEARING TREES OR OTHER OFFICIAL ACCESSORIES FOUND

A 20" FIR BEARS S36°W, 5.9 FT., DAMAGED
A 16" W.L. STUMP BEARS N42¼°W, 21.8 FT. BT VISIBLE

PHOTO IDENTIFICATION DATA

Photo No. _____
Filed At. _____
Object Ident. _____
Ident. By _____
Signature

DESCRIBE CORNER LOCATION RELATIVE TO NEAR-BY FEATURES, ALSO HOW TO REACH CORNER

FROM THE POSTED LINE WHERE IT CROSSES 2110-320, FOLLOW THE POSTED LINE 1/2 MILE EAST TO CORNER.

PLANE COORDINATE POSITION DATA


State _____ Zone _____
X _____
Y _____
Estab. By _____
Agency

Signature [Signature] Title LS 1848 Division _____ Headquarters _____ Date 10-83 FS-7100-52 (3/68)

CORNER RECORD (PERPETUATION)

MONUMENT: DESCRIBE NEW MONUMENT SET, OR WORK DONE TO PRESERVE EXISTING MONUMENT

SET 2 1/2" X 30" ALUMINUM CAPPED ALUMINUM PIPE RISING 7" , MARKED:

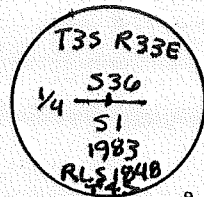

9

ACCESSORIES : DESCRIBE NEW BT'S WITNESS OBJECTS ETC. ESTABLISHED, OR WORK DONE TO PRESERVE EXISTING EVIDENCE

AN 8 1/2" W.L. BEARS N27°E, 25.7 FT. B 3/5 1/4 S36 BT

A 13 1/2" W.L. BEARS S62 3/4°E, 17.0 FT. B 3/5 1/4 S1 BT

10

Work Done By B.A. SUTTON Title SURVEYOR Date 10-83 State Registration No. or Agency LS 1848

Certified Cor. Record Prepared? Yes No Filed At: UNION CO. SURVEYOR'S OFFICE Date

11

REMARKS

12

Index File No. 2-23 T. 35 R. 33E W.M. Tract or Surv. No. Cor. 2315

13