

Index

File No. A-9T 4S R. 33EMerid. Willamette

(PA)

CORNER RECORD (SEARCH)

(Ref. FSM 7151.4)

R.D. UkiahN.F. UmatillaCounty UmatillaState Oregon


Tract or

Survey No. _____

Cor.

No. A-9

CORNER DIAGRAM

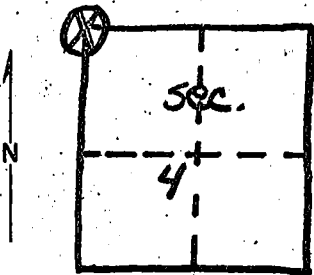

DESCRIBE CORNER MONUMENT FOUND

None was found.

DESCRIBE BEARING TREES OR OTHER OFFICIAL ACCESSORIES FOUND

Found one Bearing tree Lodge pole. pine 11" in diameter in T3S R33E S33 was very Ledgeable, very good shape.

PHOTO IDENTIFICATION DATA

Photo No. _____

Filed At. _____

Object Ident. _____

Ident. By _____

Signature _____

PLANE COORDINATE POSITION DATA

State _____ Zone _____

X _____

Y _____

Estab. By _____

Agency _____

DESCRIBE CORNER LOCATION RELATIVE TO NEAR-BY FEATURES, ALSO HOW TO REACH CORNER

Went east from $\frac{1}{4}$ corner, T4S R33E spot 5 and came to section corner. Needs corner reestablished and 3 new bearing trees.

Signature

MLC & C+B

Title

GS5

Division

USFS

Headquarters

UKIAH

Date

7100-52-(3/68)

5