


CERTIFIED RECORD OF LAND CORNER MONUMENTATION

History of original corner establishment:

None

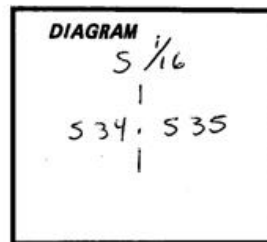

4-17

Description of corner evidence found:

None

Description of monument and accessories I established to perpetuate the original location of this corner:

Set a 2 1/2" Brass Cap on a 2 1/2" x 30" galvanized pipe set 24" in ground mkd as shown:

From which:

A 12" Pine bears N 24°30' W, 60.9 ft. scribed 1/16 S 34 BT
A 40" Pine bears N 61°30' E, 162.0 ft. scribed 1/16 S 35 BT


Blazes are painted red and have red bands painted around them.

Tress have signs numbers 54-3, 54-9 and brass washers stamped PLS 933 to them.

Bearings were run with a staff compass set at a declination of 19°30'E distances were measured with a steel tape to the center of the tree.

This corner was set Oct. 2, 1983.

By: Rod Panches
Witness: Brent Reynolds

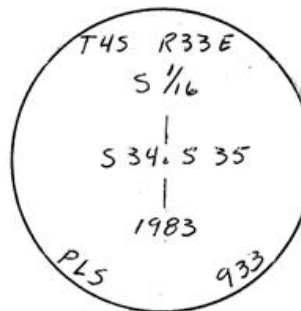

Office of..... County Surveyor..... Umatilla
 Oregon..... County of.....
 State of..... I hereby certify that the within instrument was filed in this office
 for record on the 26th day of November, 1984
 by Betty Cochran
 (COUNTY OFFICIAL) (DEPUTY)