

OREGON CORNER RESTORATION FORM

SECTION 16 TOWNSHIP 5N RANGE 28E J-11

COUNTY: UMATILLA DATE 4/90

CORNER DESIGNATION

N 1/4 Corner


- CONDITION REPORT ONLY
- NOT FOUND
- RENEWED
- UNRECORDED
- SURVEYED IN
- REFERENCED OUT

PREVIOUS RENEWALS/SURVEYS, ETC.

Original survey under Contract #101 by Davenport in 1861. In 1943 Price did a Dependent Resurvey.

MONUMENTS & ACCESSORIES FOUND: Condition and Source

Found 3 5/8" diameter Brass Disc, marked as shown below, 0.4 feet below the surface of ground. Price 1943

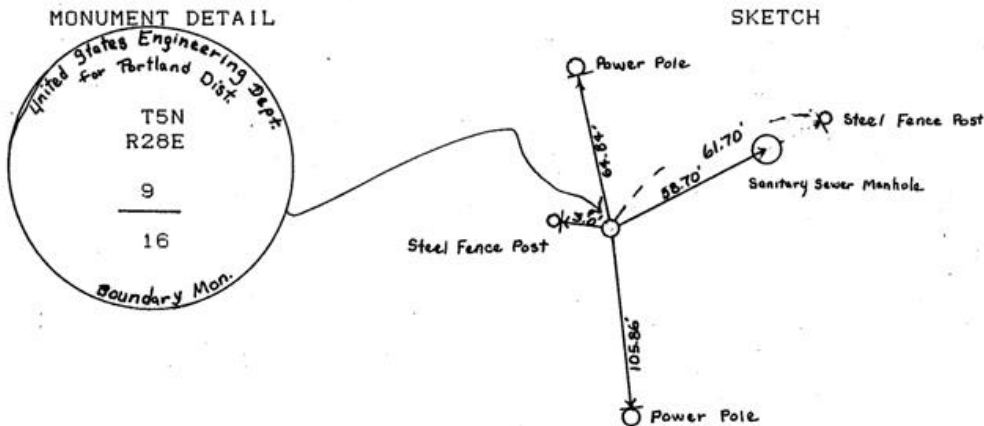

MONUMENT SET (PROCEDURES AND DESCRIPTION)

NEW ACCESSORIES

From which  
 Alum. Tag #951 in power pole Bears N 12° 15'W 64.84 feet  
 Center of Sanitary Sewer Manhole lid Bears N 62° 06'E 58.70 feet. Also a steel fence post set on same bearing, 61.70 feet  
 Tag #951 in power pole Bears S 07° 23'E 105.86 feet  
 Steel fence post Bears N 83° 35'W 3.00 feet.  
 Attached Bearing Object, Witness Cor. signs to steel fence posts and power poles.

LOCATION & COMMENTS

From overpass of I 82 and 3rd Street Umatilla go 0.3 miles East on 3rd St., then 630 feet South on a roadway

RECEIVED BY  
 Umatilla County Surveyor  
 Date 1-91  
 Rec'd By [Signature]  
 No. 91-01-B

SURVEYOR'S SEAL  
 COMPASS DEC.  
 FIRM EDWARDS SURVEYING  
 P.O. BOX 763, HERMISTON,  
 OREGON, 97838  
 PARTY CHIEF D. EDWARDS  
 NOTES  
 WITNESS J. COPPOCK

REGISTERED PROFESSIONAL LAND SURVEYOR  
 G. Dennis Edwards  
 OREGON  
 JULY 16, 1971  
 G. DENNIS EDWARDS  
 951