

**OREGON CORNER RESTORATION FORM**

**Section:** 18 – 19  
**Township:** 5 North  
**Range:** 28 East of the Willamette Meridian  
**County:** Umatilla  
**Date:**

**Corner Indexing Information:**  
**Township 5N Range 28E Corner Code N-3 (Willamette Meridian)**  
**Additional Identifier:** Quarter corner between Sections 18 & 19


**Oregon Plane Coordinates:** N: 819228.39 E: 8492428.81 **Zone:** North **Order:** second  
**Datum:** NAD83-2011(epoch 2010) **Convergence:** N00°48'32W **Scale Factor:**1.000044268448  
**Previous Renewals/Surveys, etc.:**

1861: Post, mound, pits, & charred stake (Davenport, General Land Office Contract #101)  
1975: No evidence found; set 2.5" iron post with brass cap in East-West fence at proportionate distance between 1972 Staebler brass cap at N-1 and a concrete post with nail at N-5 (Tuers, BLM Group No. 864 Special Instructions) (PBS note: we have rejected Staebler's monument at N-1 which Tuers used for proportioning in this corner, however we have accepted Tuers' monument due to the dependence thereon by several subdivisions within Section 18.)

**Monument(s) & Accessories Found (Condition & Source):**  
3" brass cap 0.4' deep, 0.4'S of an E – W fence, T-post with witness post sign and bearing tag marked "2.53FT S0°E 5N 28E 18 3-2-98 LS 1106".

**Monument Set (Procedures & Description):**  
N/A

**Monument Detail:**

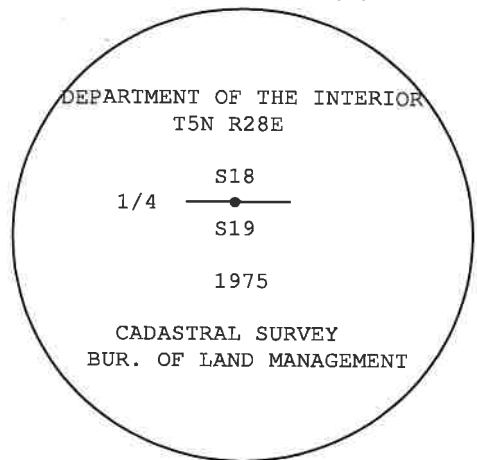

**New Accessories: WE SET:**

A 5/8" iron rebar with plastic cap stamped "WA19619 OR02820" which bears N88°50'11"E 63 feet from the corner; set T-post & bearing tag alongside, 0.5 feet South of fence;  
A 5/8" iron rebar with plastic cap stamped "WA19619 OR02820" which bears S49°25'58"E 68.56 feet from the corner; RM is buried 2 feet below surface with bearing tag wired thereto;  
A 5/8" iron rebar with plastic cap stamped "PBS WA-19619 OR-2820" which bears S14°40'04"E 72.60 feet from the corner; RM is buried 2 feet below surface with bearing tag wired thereto;  
A 5/8" iron rebar with plastic cap stamped "PBS WA-19619 OR-2820" which bears N89°00'26"W 57.61 feet from the corner; set T-post & bearing tag alongside, 0.5feet South of fence.

**Location & Comments:**  
Corner falls approximately 130 feet South of centerline of Grant Street.

**Compass Declination:**  
All accessories tied with State Plane grid bearings.

**Firm/Agency:** PBS Engineering & Environmental, Inc  
5 N. Colville  
Walla Walla WA 99362

**Witness:** Mark F. Wendover  
Jered M. Clifford  
A.J. Nickels

**Surveyor's Seal**



RENEWS 12/31/2025  
1/24/2024