

OREGON CORNER RESTORATION FORM

Section: 17 – 20
Township: 5 North
Range: 28 East of the Willamette Meridian
County: Umatilla
Date: 12/23/2022

Corner Indexing Information: Township 5N Range 28E Corner Code N-7 (Willamette Meridian)

Additional Identifier: Quarter corner between Sections 17 & 20

Oregon Plane Coordinates: N: 819310.29 E: 8497720.01 **Zone:** North **Order:** Second

Datum: NAD83-2011(epoch 2010) **Convergence:** N 00°49'24.98" W **Scale Factor:** 0.99996234779253

Previous Renewals/Surveys, etc.:

1861: Post, mound, pits, & charred stake (Davenport, General Land Office Contract #101)

1907: Post found (J. Kimbrell, C.S. 251)

1948: Stone with "X" (Storms, C.S. Q-1543-B)

1975: No evidence found. Set 2-1/2" iron post with brass cap at proportionate distance. 17" utility pole bears S53°W, 30.5 lks.; 10" utility pole bears N42°30', 20 lks.; Set steel fence post alongside corner; 3/8" iron rebar by Krumbein, 1975, bears North, 3.2 lks. (Tuers, Bureau of Land Management, Group No. 864 Instructions dated 4-11-1975)

1990: Found Tuers brass cap; Set (2) steel fence posts with witness post sign & bearing tree sign N87°06'50"E, 2.07', S26°27'50"E, 0.79'; Set (2) aluminum tags #951 & bearing tree sign on utility poles S(sic)42°22'30"W, 12.57', S52°08'50"W, 19.00' (Edwards, LCR 91-001-B)

1998: Found monument & accessories per LCR 91-001-B. Notes that punch mark falls 0.02' North by 0.04' West of center of cap (W. Wells, LCR 98-101-C)

Monument(s) & Accessories Found (Condition & Source):

3-1/4" brass cap flush, 0.3' East of Northeast corner railroad tie post at corner of fence running North & East; No punch mark observed, tied at center of line running East-West across brass cap. U-post with blank sign & bearing tree sign bears East, 2.0'; T-post with bearing tree sign falls 0.7' S. by 0.3' E.; (2) Utility poles with aluminum tag #951, witness post sign, & bearing tree sign bear N42°54'35"W, 12.41', S51°43'03"W, 18.84'.

Monument Set (Procedures & Description):

Found 3-1/4" brass cap as described in good condition.

Monument Detail:

U.S DEPT. OF THE INTERIOR

T5N R28E

1/4 S17
S20

1975

CADASTRAL SURVEY

BUR. OF LAND MANAGEMENT

New Accessories: WE SET:

No new accessories set.

Location & Comments:

To access monument, take Powerline Road to Canal Road


Compass Declination:

All accessories tied with State Plane grid bearings.

Firm/Agency: PBS Engineering & Environmental, Inc.
5 N. Colville Street
Walla Walla, WA 99362

Witness: Eduardo C. Ibarra
Hayden J. Lomeli
Felipe G. Hernandez

Surveyor's Seal

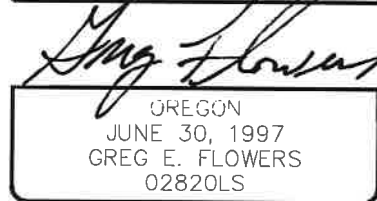

RENEWS 12/31/2025

12/28/2023