

**OREGON CORNER RESTORATION FORM**

**Section:** 33 – 34  
**Township:** 5 North  
**Range:** 28 East of the Willamette Meridian  
**County:** Umatilla  
**Date:** January 2024

**Corner Indexing Information:** Township 5N Range 28E Corner Code X-13 (Willamette Meridian)  
**Additional Identifier:** Quarter corner between Sections 33 & 34

**Oregon Plane Coordinates:** N: 806243.87 E: 8505889.78 **Zone:** North **Order:** Second  
**Datum:** NAD83-2011(epoch 2010) **Convergence:** N00°50'44"W **Scale Factor:** 1.000044268448

**Previous Renewals/Surveys, etc.:**

1861: Set post, mound, pits, & charred stake (Davenport, G.L.O. contract #101)  
1909: NF; reset by single-proportion between R-13 & Z-13 (J. Kimbrell, C.S. 283)  
1910: NF; set pipe by double-proportion between V-13 & Z-13, V-1 (calc.) & V-25 (J. Kimbrell, C.S. 308)  
1910: Found, not described (J. Kimbrell, C.S. 317)  
1910: Found at mid-point between V-13 & Z-13, not described (J. Kimbrell, C.S. 326)  
1977: Found 1/2" iron pipe (Edwards, C.S. M-052-AX)  
1977: Found 1-1/2" iron pipe (Edwards, C.S. M-070-AX)  
1978: Found 1-1/2" iron pipe (Edwards, C.S. P-088-A)  
1979: Found 1/2" iron pipe (Edwards, C.S. Q-0949-A)  
1995: Found 5/8" rebar driven in 1-1/2" iron pipe. which was 14" below surface; a 1/2" rebar per 1979 Edwards' survey for Fox bears N58°42'W 38.68'. Set 2" aluminum cap on the 5/8" rebar; set (2) aluminum tags in power poles, N54°19'10"E 35.22', S55°09'50"E 33.64'; a 2-3/8" brass cap on 1" iron pipe bears S54°36'W 44.37' (Edwards, LCR 09-040-A)


**Monument(s) & Accessories Found (Condition & Source):**

5/8" iron rebar in a 2" iron pipe; power pole with bearing tag bears N53°04'15"E 34.95 feet from the corner; power pole with bearing tag bears S56°02'48"E 33.57 feet from the corner.

**Monument Set (Procedures & Description):**

Set 2-1/2" brass cap on existing 5/8" iron rebar.

**Monument Detail:**

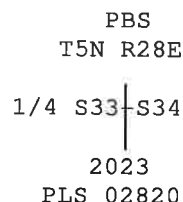

**New Accessories: WE SET:**

5/8"x30" iron rebar with yellow cap stamped "PBS WA-19619 OR-02820" which bears N52°44'04"W 38.57 feet from the corner at a stop sign;  
5/8"x30" iron rebar with yellow cap stamped "PBS WA-19619 OR-02820" which bears S47°38'54"W 30.62 feet from the corner; set bearing tag on adjacent power pole.

**Location & Comments:**

Corner lies at the intersection of Joy Lane and Sunshine Lane


**Compass Declination:**

All accessories tied with State Plane grid bearings.

**Firm/Agency:** PBS Engineering & Environmental, Inc  
5 N. Colville  
Walla Walla WA 99362

**Witness:** Jace Boland  
Bob Eisele

**Surveyor's Seal**

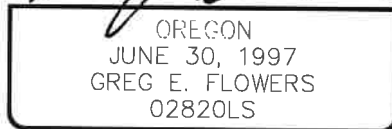

RENEWS 12/31/2025  
02/01/2024