

OREGON CORNER RESTORATION FORM

Section: 32
Township: 5 North
Range: 28 East of the Willamette Meridian
County: Umatilla
Date: January 2024

Corner Indexing Information:

Township 5N Range 28E Corner Code Z-7 (Willamette Meridian)
Additional Identifier: South quarter corner of Section 32

Oregon Plane Coordinates: N: 803517.48 E: 8497994.84 **Zone:** North **Order:** Second
Datum: NAD83-2011(epoch 2010) **Convergence:** N00°49'25"W **Scale Factor:** 1.000044268448

Previous Renewals/Surveys, etc.:

1860: Set post, mound, pits, & charred stake (Maxson & Hurd, G.L.O. Contract No. 50)
1978: Not found (Edwards, C.S. O-017-B)
1980: Set corner by tangent offset method between the S1/4 of Sec. 35 and the S.E. corner of Sec. 32; corner is in line with an old tree line running North. Set 2-1/2" brass cap 6" below road surface. (Krumbein, C.S. S-156-C) (PBS note: we presume the S/14 of Sec. 35 referred to is the 1941 brass cap by Gould in T5N R27E; the S.E. corner of Section 32 was a bent 2" pipe over a stone with X, 16.5' S. of Gould's W.C. brass cap)


Monument(s) & Accessories Found (Condition & Source):

Found 2-1/2" brass cap per C.S. S-156-C 0.3' below road surface in Country Lane.

Monument Set (Procedures & Description):

N/A

Monument Detail:

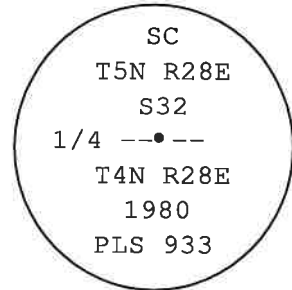

New Accessories: WE SET:

A 5/8"x30" iron rebar with plastic cap stamped "WA19619 OR02820" bears S52°49'13"W 34.63 feet from the corner; set T-post & bearing tag alongside;
A 5/8"x30" iron rebar with plastic cap stamped "WA19619 OR02820" bears S63°57'22"E 44.97 feet from the corner; set T-post & bearing tag alongside;
A 5/8"x30" iron rebar with plastic cap stamped "PBS WA19619 OR02820" bears N85°25'58"W 116.19 feet from the corner; set bearing tag on adjacent power pole;
A 5/8"x30" iron rebar with plastic cap stamped "PBS WA-19619 OR-2820" bears N76°01'99"E 52.33 feet from the corner; set bearing tag on adjacent power pole.

Location & Comments:

Corner falls in Country Lane

Compass Declination:

All accessories tied with State Plane grid bearings.


Firm/Agency: PBS Engineering & Environmental, Inc
5 N. Colville
Walla Walla WA 99362

Witness: Mark F. Wendover
Jered M. Clifford
A.J. Nickels

Surveyor's Seal



Greg Flowers

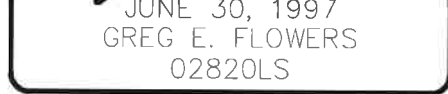

RENEWS 12/31/2025
1/25/2024