

# OREGON CORNER RESTORATION FORM

SECTION 7, 12, 13, 18 TOWNSHIP 5 NORTH RANGE 29 EAST, RANGE 30 EAST J-25  
 COUNTY : UMATILLA DATE DEC/22

CORNER DESIGNATION  
 SECTION CORNER

- CONDITION REPORT ONLY
- NOT FOUND
- RENEWED
- UNCOVERED
- SURVEYED IN
- REFERENCED


PREVIOUS RENEWALS / SURVEYS, ETC.

SURVEYED IN 1861 BY PAYNE UNDER CONTRACT #100, HE SET CHARRED STAKE WITH MOUND.  
 IN 1949 STRANIX FOUND A STAKE AND SET A CONCRETE MONUMENT.

MONUMENTS AND ACCESSORIES FOUND: CONDITION AND SOURCE

- FOUND 3" BRASS CAP WITH CONCRETE COLLAR STAMPED AS BELOW.
- FOUND 5/8" IRON ROD WITH YELLOW PLASTIC CAP STAMPED LS 951 BEARS S 88°19'30" E, 30.17'.
- FOUND 5/8" IRON ROD WITH YELLOW PLASTIC CAP STAMPED LS 951 BEARS S 19°35'41" E, 61.48'.
- FOUND 5/8" IRON ROD WITH YELLOW PLASTIC CAP STAMPED LS 951 BEARS S 01°03'27" E, 43.91'.
- FOUND 5/8" IRON ROD WITH YELLOW PLASTIC CAP STAMPED LS 951 BEARS N 85°38'14" W, 16.05'.
- FOUND 5/8" IRON ROD WITH YELLOW PLASTIC CAP STAMPED LS 951 BEARS N 03°47'48" W, 55.27'.

MONUMENT DETAIL

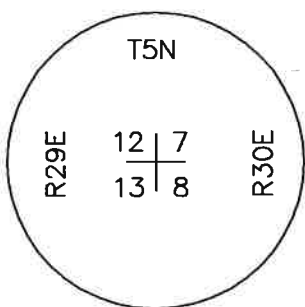

NAD 83/91  
 OREGON STATE PLANE  
 INTERNATIONAL FEET  
 825316.16  
 8553140.44

MONUMENT SET ( PROCEDURES AND DESCRIPTION )

NEW ACCESSORIES FROM WHICH

LOCATION AND COMMENTS

ON WEST BOUNDARY OF A  
 SMALL STATE PARK +/- 400  
 FEET NORTH OF HIGHWAY 730  
 AT A FENCE CORNER.

FIRM/AGENCY

PRIMM LAND SURVEYING, INC.  
 P.O. BOX 1322  
 HERMISTON, OREGON 97838

LAND SURVEYOR

BRIT L. PRIMM

WITNESS

KEITH P. PRIMM

SURVEYOR'S SEAL

REGISTERED  
 PROFESSIONAL  
 LAND SURVEYOR

*Brit L. Primm*  
 OREGON  
 JULY 13, 1999  
 BRIT L. PRIMM  
 48509

EXPIRATION DATE: 12/31/24