

OREGON CORNER RESTORATION FORM

SECTION 7, 8, 17, 18 TOWNSHIP 5 NORTH RANGE 29 EAST
COUNTY : UMATILLA DATE DEC/22

J-5

CORNER DESIGNATION
SECTION CORNER

CONDITION REPORT ONLY
 NOT FOUND
 RENEWED
 UNCOVERED
 SURVEYED IN
 REFERENCED


PREVIOUS RENEWALS / SURVEYS, ETC.

SURVEYED IN 1861 BY DAVENPORT UNDER CONTRACT #101, HE SET POST AND MADE MOUND.
IN 1991 LS 951 FOUND A MOUND OF STONE AND SET A 2 1/2" BRASS CAP IN CONCRETE.

MONUMENTS AND ACCESSORIES FOUND: CONDITION AND SOURCE

FOUND 2 1/2" BRASS CAP STAMPED AS BELOW.
FOUND RAIL ROAD SPIKE STAMPED 951 BEARS N 02°21'48" E, 40.75'.
FOUND 1" SQUARE ROD BEARS S 79°36'48" E, 87.14'.
FOUND 5/8" IRON ROD WITH YELLOW PLASTIC CAP STAMPED LS 951 BEARS S 01°23'05" W, 54.67'.
FOUND 5/8" IRON ROD WITH YELLOW PLASTIC CAP STAMPED LS 951 BEARS S 82°20'40" W, 24.72'.

MONUMENT DETAIL

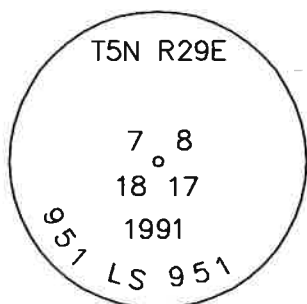

NAD 83/91
OREGON STATE PLANE
INTERNATIONAL FEET

824942.86
8526851.40

MONUMENT SET (PROCEDURES AND DESCRIPTION)

NEW ACCESSORIES FROM WHICH

LOCATION AND COMMENTS

FROM NORTHWEST CORNER OF
WANAKET WILDLIFE AREA ON
MCNARY BEACH ROAD GO EAST
+/- 2 MILES AND NORTH +/-
0.25 MILES TO THE CORNER.
CORNER LIES +/- 60' SOUTH
OF EDGE OF BLUFF.

FIRM/AGENCY

PRIMM LAND SURVEYING, INC.
P.O. BOX 1322
HERMISTON, OREGON 97838

LAND SURVEYOR

BRIT L. PRIMM

WITNESS

KEITH P. PRIMM

SURVEYOR'S SEAL

REGISTERED
PROFESSIONAL
LAND SURVEYOR

OREGON
JULY 13, 1999
BRIT L. PRIMM
48509

EXPIRATION DATE: 12/31/24