

OREGON CORNER RESTORATION FORM

SECTION 14, 15 TOWNSHIP 5 NORTH RANGE 29 EAST

L-17

COUNTY : UMATILLA DATE DEC/22

CORNER DESIGNATION

1/4 CORNER

CONDITION REPORT ONLY

NOT FOUND

RENEWED

UNCOVERED

SURVEYED IN

REFERENCED


PREVIOUS RENEWALS / SURVEYS, ETC.

SURVEYED IN 1861 BY DAVENPORT UNDER CONTRACT #101, HE SET POST AND MADE MOUND.
IN 1974 US ARMY CORPS OF ENGINEERS SET A 3 1/2" BRASS CAP NOT STAMPED AS 1/4 CORNER.
IN 2005 LS 951 SET A 2 3/8" BRASS CAP AND PLACED ROCKS AROUND.

MONUMENTS AND ACCESSORIES FOUND: CONDITION AND SOURCE

FOUND 2 3/8" BRASS CAP STAMPED AS BELOW.
FOUND 3 1/2" BRASS CAP IN CONCRETE BEARS S 19°14'18" E, 82.17'.
FOUND 5/8" IRON ROD WITH YELLOW PLASTIC CAP STAMPED LS 951 BEARS N 17°58'54" E, 26.64'.
FOUND 5/8" IRON ROD WITH YELLOW PLASTIC CAP STAMPED LS 951 BEARS N 89°48'33" W, 20.00'.
FOUND 2 3/8" BRASS CAP STAMPED W.C. BEARS N 69°26'10" E, 50.00'.

MONUMENT DETAIL

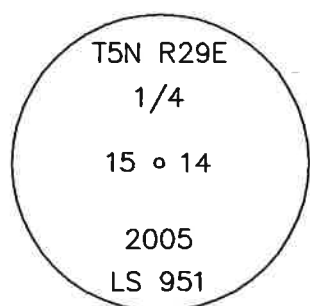

NAD 83/91
OREGON STATE PLANE
INTERNATIONAL FEET

822515.62
8542760.78

MONUMENT SET (PROCEDURES AND DESCRIPTION)

NEW ACCESSORIES FROM WHICH

LOCATION AND COMMENTS

FROM THE PICNIC AREA OF HAT
ROCK STATE PARK GO EASTERLY
+/- 1200 ALONG THE BOTTOM OF
A DRAW TO THE CORNER.

FIRM/AGENCY

PRIMM LAND SURVEYING, INC.
P.O. BOX 1322
HERMISTON, OREGON 97838

LAND SURVEYOR

BRIT L. PRIMM

WITNESS

KEITH P. PRIMM

SURVEYOR'S SEAL

REGISTERED
PROFESSIONAL
LAND SURVEYOR

OREGON
JULY 13, 1999
BRIT L. PRIMM
48509

EXPIRATION DATE: 12/31/24

23-012-C