

# OREGON CORNER RESTORATION FORM

SECTION 18, 19 TOWNSHIP 5 NORTH RANGE 29 EAST  
 COUNTY : UMATILLA DATE DEC/22

N-3

CORNER DESIGNATION

1/4 CORNER

- CONDITION REPORT ONLY
- NOT FOUND
- RENEWED
- UNCOVERED
- SURVEYED IN
- REFERENCED

PREVIOUS RENEWALS / SURVEYS, ETC.



SURVEYED IN 1861 BY DAVENPORT UNDER CONTRACT #101, HE SET POST AND MADE MOUND.  
 IN 2005 LS 951 SET A 2 3/8" BRASS CAP IN CONCRETE.

MONUMENTS AND ACCESSORIES FOUND: CONDITION AND SOURCE

FOUND 1" X 30" IRON PIPE WITH 2 3/8" BRASS CAP LAYING ON GROUND STAMPED AS BELOW.  
 FOUND 5/8" IRON ROD WITH YELLOW PLASTIC CAP STAMPED LS 951 BEARS N 58°10'49" E, 81.83'.  
 FOUND 5/8" IRON ROD WITH YELLOW PLASTIC CAP STAMPED LS 951 BEARS N 28°59'05" E, 58.27'.  
 FOUND 5/8" IRON ROD WITH YELLOW PLASTIC CAP STAMPED LS 951 BEARS N 13°01'26" W, 61.86'.  
 FOUND 5/8" IRON ROD WITH YELLOW PLASTIC CAP STAMPED LS 951 BEARS N 23°01'58" W, 68.69'.

MONUMENT DETAIL

FOUND 2 3/8" BRASS CAP  
 LAYING ON GROUND

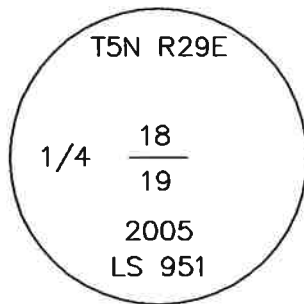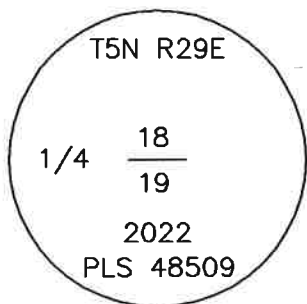

NAD 83/91  
 OREGON STATE PLANE  
 INTERNATIONAL FEET

819611.04  
 8524283.16

MONUMENT SET ( PROCEDURES AND DESCRIPTION )

SET 2" ALUMINUM CAP IN CONCRETE STAMPED AS ABOVE FROM ACCESSORIES FOUND.

NEW ACCESSORIES FROM WHICH

LOCATION AND COMMENTS

FROM INTERSECTION OF CRAIG ROAD  
 AND HIGHWAY 730, GO WESTERLY  
 ALONG HIGHWAY 730 +/- 0.5  
 MILES. CORNER LIES NORTH OF  
 HIGHWAY +/- 60' SOUTH OF NORTH  
 R.O.W. FENCE.

FIRM/AGENCY

PRIMM LAND SURVEYING, INC.  
 P.O. BOX 1322  
 HERMISTON, OREGON 97838

LAND SURVEYOR

BRIT L. PRIMM

WITNESS

KEITH P. PRIMM

SURVEYOR'S SEAL

REGISTERED  
 PROFESSIONAL  
 LAND SURVEYOR

*Brit L. Primm*  
 OREGON  
 JULY 13, 1999  
 BRIT L. PRIMM  
 48509

EXPIRATION DATE: 12/31/24