

OREGON CORNER RESTORATION FORM

SECTION 16, 17, 20, 21 TOWNSHIP 5 NORTH RANGE 29 EAST
 COUNTY : UMATILLA DATE DEC/22

N-9

CORNER DESIGNATION
 SECTION CORNER

- CONDITION REPORT ONLY
- NOT FOUND
- RENEWED
- UNCOVERED
- SURVEYED IN
- REFERENCED

PREVIOUS RENEWALS / SURVEYS, ETC.

SURVEYED IN 1861 BY DAVENPORT UNDER CONTRACT #101, HE SET POST AND MADE MOUND.
 IN 1991 LS 951 SET A 2 3/8" BRASS CAP.
 IN 2005 LS 951 SET A 2 3/8" BRASS CAP.



MONUMENTS AND ACCESSORIES FOUND: CONDITION AND SOURCE

FOUND 2 3/8" BRASS CAP STAMPED AS BELOW.
 FOUND 2 3/8" BRASS CAP WC STAMPED AS BELOW BEARS N 85°03'31" E, 3.56'.
 FOUND 2" IRON PIPE BEARS S 89°50'34" W, 68.68'.
 FOUND 3 3/4" BRASS CAP STAMPED AS BELOW BEARS N 18°20'18" E, 19.25'.
 FOUND 5/8" IRON ROD WITH YELLOW PLASTIC CAP STAMPED LS 951 BEARS N 43°39'32" W, 60.72'.

MONUMENT DETAIL

2 3/8" BRASS CAP WC

3 3/4" BRASS CAP

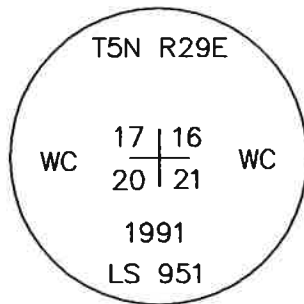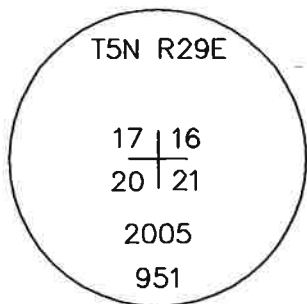

NAD 83/91
 OREGON STATE PLANE
 INTERNATIONAL FEET

819658.61
 8532234.33

MONUMENT SET (PROCEDURES AND DESCRIPTION)

NEW ACCESSORIES FROM WHICH

LOCATION AND COMMENTS

FROM INTERSECTION OF SALMON POINT DRIVE AND HIGHWAY 730 GO WEST +/- 1 MILE. CORNER FALLS NORTH OF HIGHWAY 730 +/- 1700 FEET.

FIRM/AGENCY

PRIMM LAND SURVEYING, INC.
 P.O. BOX 1322
 HERMISTON, OREGON 97838

LAND SURVEYOR

BRIT L. PRIMM

WITNESS

KEITH P. PRIMM

SURVEYOR'S SEAL

REGISTERED
 PROFESSIONAL
 LAND SURVEYOR

OREGON
 JULY 13, 1999
 BRIT L. PRIMM
 48509

EXPIRATION DATE: 12/31/24