

OREGON CORNER RESTORATION FORM

SECTION 21, 22, 27, 28 TOWNSHIP 5 NORTH RANGE 29 EAST

R-13

COUNTY : UMATILLA DATE DEC/22

CORNER DESIGNATION

SECTION CORNER

- CONDITION REPORT ONLY
- NOT FOUND
- RENEWED
- UNCOVERED
- SURVEYED IN
- REFERENCED


PREVIOUS RENEWALS / SURVEYS, ETC.

SURVEYED IN 1861 BY DAVENPORT UNDER CONTRACT #101, HE SET POST AND MADE MOUND.
LS 951 REPORTS RAIL ROAD SPIKE OF COMMON REPORT AT ROAD INTERSECTION USED FOR MANY YEARS BY SURVEYORS.
IN 2005 LS 951 REMOVES RAIL ROAD SPIKE AND SETS 2" ALUMINUM CAP.

MONUMENTS AND ACCESSORIES FOUND: CONDITION AND SOURCE

FOUND 2" ALUMINUM CAP STAMPED AS BELOW.
FOUND 5/8" IRON ROD WITH PLASTIC CAP STAMPED LS 951 BEARS N 02°20'13" E, 20.70'.
FOUND 5/8" IRON ROD WITH PLASTIC CAP STAMPED LS 951 BEARS N 56°24'26" W, 37.01'.

MONUMENT DETAIL

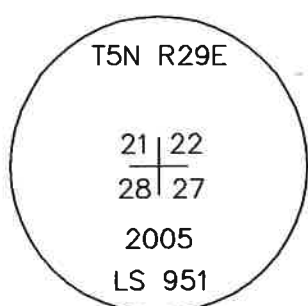

NAD 83/91
OREGON STATE PLANE
INTERNATIONAL FEET

814520.71
8537610.75

MONUMENT SET (PROCEDURES AND DESCRIPTION)

NEW ACCESSORIES FROM WHICH

SET 5/8" X 30" IRON ROD WITH YELLOW PLASTIC CAP STAMPED PLS LS 48509 BEARS S 26°28'55" E, 35.80'.
SET 5/8" X 30" IRON ROD WITH YELLOW PLASTIC CAP STAMPED PLS LS 48509 BEARS S 29°24'30" W, 47.29'.

LOCATION AND COMMENTS

CORNER FALLS AT INTERSECTION OF
TABOR ROAD AND PROGRESS ROAD.

FIRM/AGENCY

PRIMM LAND SURVEYING, INC.
P.O. BOX 1322
HERMISTON, OREGON 97838

LAND SURVEYOR

BRIT L. PRIMM

WITNESS

KEITH P. PRIMM

SURVEYOR'S SEAL

REGISTERED
PROFESSIONAL
LAND SURVEYOR

OREGON
JULY 13, 1999
BRIT L. PRIMM
48509

EXPIRATION DATE: 12/31/24