

OREGON CORNER RESTORATION FORM

SECTION 23, 26 TOWNSHIP 5 NORTH RANGE 29 EAST

R-19

COUNTY : UMATILLA DATE DEC/22

CORNER DESIGNATION

1/4 CORNER

- CONDITION REPORT ONLY
- NOT FOUND
- RENEWED
- UNCOVERED
- SURVEYED IN
- REFERENCED


PREVIOUS RENEWALS / SURVEYS, ETC.

SURVEYED IN 1861 BY DAVENPORT UNDER CONTRACT #101, HE SET POST AND MADE MOUND.
IN 2005 LS 951 SET 2 3/8" BRASS CAP.

MONUMENTS AND ACCESSORIES FOUND: CONDITION AND SOURCE

FOUND 2 3/8" BRASS CAP STAMPED AS BELOW.
FOUND 5/8" IRON ROD WITH PLASTIC CAP STAMPED LS 951 BEARS S 05°14'12" W, 226.54'.

MONUMENT DETAIL

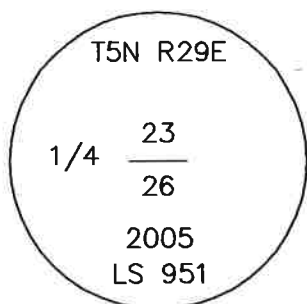

N.T.S

NAD 83/91
OREGON STATE PLANE
INTERNATIONAL FEET

814661.30
8545542.54

MONUMENT SET (PROCEDURES AND DESCRIPTION)

NEW ACCESSORIES FROM WHICH

SET 5/8" X 30" IRON ROD WITH YELLOW PLASTIC CAP STAMPED PLS LS 48509 BEARS S 73°06'31" E, 274.20'.
SET 5/8" X 30" IRON ROD WITH YELLOW PLASTIC CAP STAMPED PLS LS 48509 BEARS S 45°06'54" E, 217.59'.
SET 5/8" X 30" IRON ROD WITH YELLOW PLASTIC CAP STAMPED PLS LS 48509 BEARS S 20°18'40" E, 202.50'.

LOCATION AND COMMENTS

FROM INTERSECTION OF WALLS ROAD AND MARKS ROAD GO NORTH ALONG MARKS ROAD +/- 0.4 MILES TO WHERE ROAD TURNS IN A NORTHEASTERLY DIRECTION, FOLLOW ROAD FOR +/- 0.44 MILES TO WESTERLY EDGE OF CROP CIRCLE THEN GO IN A CLOCKWISE DIRECTION AROUND CROP CIRCLE +/- 0.47 MILES TO CORNER. CORNER FALLS ON EDGE OF CROP CIRCLE.

FIRM/AGENCY

PRIMM LAND SURVEYING, INC.
P.O. BOX 1322
HERMISTON, OREGON 97838

LAND SURVEYOR

BRIT L. PRIMM

WITNESS

KEITH P. PRIMM

SURVEYOR'S SEAL

REGISTERED
PROFESSIONAL
LAND SURVEYOR

OREGON
JULY 13, 1999
BRIT L. PRIMM
48509

EXPIRATION DATE: 12/31/24