

# OREGON CORNER RESTORATION FORM

SECTION 20, 21, 28, 29 TOWNSHIP 5 NORTH RANGE 29 EAST  
COUNTY : UMATILLA DATE DEC/22

R-9

CORNER DESIGNATION  
SECTION CORNER

CONDITION REPORT ONLY  
 NOT FOUND  
 RENEWED  
 UNCOVERED  
 SURVEYED IN  
 REFERENCED


PREVIOUS RENEWALS / SURVEYS, ETC.

SURVEYED IN 1861 BY DAVENPORT UNDER CONTRACT #101, HE SET POST AND MADE MOUND.  
IN 1910 KIMBRELL SET 2" IRON PIPE.

MONUMENTS AND ACCESSORIES FOUND: CONDITION AND SOURCE

FOUND 2" IRON PIPE.  
FOUND 5/8" IRON ROD WITH PLASTIC CAP STAMPED LS 951 BEARS S 89°41'16" E, 34.70'.  
FOUND 5/8" IRON ROD WITH PLASTIC CAP STAMPED LS 951 BEARS N 64°34'17" E, 87.95'.  
FOUND 5/8" IRON ROD WITH PLASTIC CAP STAMPED LS 951 BEARS N 77°48'20" E, 99.10'.

MONUMENT DETAIL

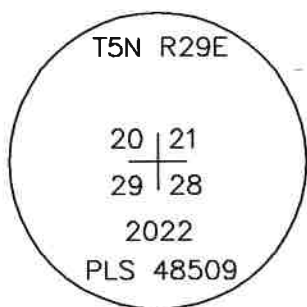

NAD 83/91  
OREGON STATE PLANE  
INTERNATIONAL FEET

814390.01  
8532323.11

MONUMENT SET ( PROCEDURES AND DESCRIPTION )

SET 5/8" X 30" IRON ROD (INSIDE FOUND 2" IRON PIPE) WITH 2" ALUMINUM CAP STAMPED AS ABOVE.

NEW ACCESSORIES FROM WHICH

SET 5/8" X 30" IRON ROD WITH YELLOW PLASTIC CAP STAMPED PLS LS 48509 BEARS N 00°11'29" W, 32.32'.

LOCATION AND COMMENTS

FROM INTERSECTION OF GOLDA ROAD  
AND PROGRESS ROAD GO WEST  
+/- 0.5 MILES TO CORNER.

FIRM/AGENCY

PRIMM LAND SURVEYING, INC.  
P.O. BOX 1322  
HERMISTON, OREGON 97838

LAND SURVEYOR

BRIT L. PRIMM

WITNESS

KEITH P. PRIMM

SURVEYOR'S SEAL

REGISTERED  
PROFESSIONAL  
LAND SURVEYOR

*Brit L. Primm*  
OREGON  
JULY 13, 1999  
BRIT L. PRIMM  
48509

EXPIRATION DATE: 12/31/24