

# OREGON CORNER RESTORATION FORM

SECTION 29, 30 TOWNSHIP 5 NORTH RANGE 29 EAST  
COUNTY : UMATILLA DATE DEC/22

T-5

CORNER DESIGNATION

1/4 CORNER

- CONDITION REPORT ONLY
- NOT FOUND
- RENEWED
- UNCOVERED
- SURVEYED IN
- REFERENCED


PREVIOUS RENEWALS / SURVEYS, ETC.

SURVEYED IN 1861 BY DAVENPORT UNDER CONTRACT #101, HE SET POST AND MADE MOUND.  
IN 1910 KIMBRELL SET A 1 1/2" IRON PIPE.  
IN 1992 LS 951 SET A 1/2" IRON ROD INSIDE KIMBRELLS IRON PIPE.

MONUMENTS AND ACCESSORIES FOUND: CONDITION AND SOURCE

FOUND 1/2" IRON ROD INSIDE 1 1/2" IRON PIPE.  
FOUND 5/8" IRON ROD WITH YELLOW PLASTIC CAP STAMPED LS 951 BEARS S 65°21'46" E, 36.26'.  
FOUND 5/8" IRON ROD WITH YELLOW PLASTIC CAP STAMPED LS 951 BEARS N 38°29'24" W, 45.75'.  
FOUND 5/8" IRON ROD WITH YELLOW PLASTIC CAP STAMPED LS 951 BEARS S 15°17'32" W, 121.68'.  
FOUND 5/8" IRON ROD WITH YELLOW PLASTIC CAP STAMPED LS 951 BEARS S 26°46'36" E, 41.48'.

MONUMENT DETAIL

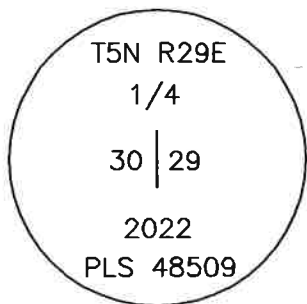

NAD 83/91  
OREGON STATE PLANE  
INTERNATIONAL FEET

811737.04  
8527052.99

MONUMENT SET ( PROCEDURES AND DESCRIPTION )

SET 5/8" X 30" IRON ROD (AT LOCATION OF FOUND 1/2" IRON ROD INSIDE FOUND 1 1/2" IRON PIPE) WITH 2" ALUMINUM CAP STAMPED AS ABOVE.

NEW ACCESSORIES FROM WHICH

LOCATION AND COMMENTS

CORNER FALLS AT INTERSECTION OF CRAIG ROAD AND SPEARMAN ROAD.

FIRM/AGENCY

PRIMM LAND SURVEYING, INC.  
P.O. BOX 1322  
HERMISTON, OREGON 97838

LAND SURVEYOR

BRIT L. PRIMM

WITNESS

KEITH P. PRIMM

SURVEYOR'S SEAL

REGISTERED  
PROFESSIONAL  
LAND SURVEYOR

OREGON  
JULY 13, 1999  
BRIT L. PRIMM  
48509

EXPIRATION DATE: 12/31/24