

OREGON CORNER RESTORATION FORM

SECTION 26, 35 TOWNSHIP 5 NORTH RANGE 29 EAST
COUNTY : UMATILLA DATE DEC/22

V-19

CORNER DESIGNATION

1/4 CORNER

- CONDITION REPORT ONLY
- NOT FOUND
- RENEWED
- UNCOVERED
- SURVEYED IN
- REFERENCED


PREVIOUS RENEWALS / SURVEYS, ETC.

SURVEYED IN 1861 BY DAVENPORT UNDER CONTRACT #101, HE SET POST AND MADE MOUND.
IN 2005 LS 951 SET A 2 3/8" BRASS CAP. NOT FOUND.

MONUMENTS AND ACCESSORIES FOUND: CONDITION AND SOURCE

FOUND 5/8" IRON ROD WITH YELLOW PLASTIC CAP STAMPED LS 951 BEARS S 79°53'01" W, 48.40'.
FOUND 5/8" IRON ROD WITH YELLOW PLASTIC CAP STAMPED LS 951 BEARS S 03°16'27" W, 9.17'.
FOUND 5/8" IRON ROD WITH YELLOW PLASTIC CAP STAMPED LS 951 BEARS S 84°37'14" E, 108.43'.

MONUMENT DETAIL

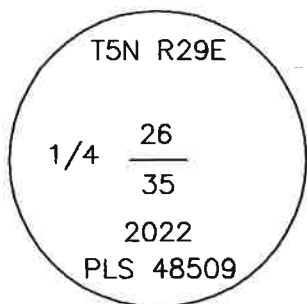

NAD 83/91
OREGON STATE PLANE
INTERNATIONAL FEET

809367.55
8545622.17

MONUMENT SET (PROCEDURES AND DESCRIPTION)

SET 5/8" X 30" IRON ROD WITH 2" ALUMINUM CAP STAMPED AS ABOVE FROM ACCESSORIES FOUND.

NEW ACCESSORIES FROM WHICH

LOCATION AND COMMENTS

FROM INTERSECTION OF MARKS
ROAD AND WALLS ROAD, GO EAST
ALONG WALLS ROAD +/- 0.5 MILES
TO CORNER. CORNER FALLS NORTH
OF EAST-WEST FENCE LINE.

FIRM/AGENCY

PRIMM LAND SURVEYING, INC.
P.O. BOX 1322
HERMISTON, OREGON 97838

LAND SURVEYOR

BRIT L. PRIMM

WITNESS

KEITH P. PRIMM

SURVEYOR'S SEAL

REGISTERED
PROFESSIONAL
LAND SURVEYOR

OREGON
JULY 13, 1999
BRIT L. PRIMM
48509

EXPIRATION DATE: 12/31/24