

OREGON CORNER RESTORATION FORM

SECTION 25, 30, 31, 36 TOWNSHIP 5 NORTH RANGE 29 EAST, RANGE 30 EAST V-25
COUNTY : UMATILLA DATE DEC/22

CORNER DESIGNATION
SECTION CORNER

CONDITION REPORT ONLY
 NOT FOUND
 RENEWED
 UNCOVERED
 SURVEYED IN
 REFERENCED


PREVIOUS RENEWALS / SURVEYS, ETC.

SURVEYED IN 1861 BY PAYNE UNDER CONTRACT #100, HE SET A POST AND MADE MOUND.
IN 2005 LS 951 SET A 2 3/8" BRASS CAP 25" BELOW THE SURFACE OF A CULTIVATED CROP.

MONUMENTS AND ACCESSORIES FOUND: CONDITION AND SOURCE

FOUND 2 3/8" BRASS CAP STAMPED AS BELOW.
FOUND 5/8" IRON ROD WITH YELLOW PLASTIC CAP STAMPED LS 951 BEARS S 84°31'21" E, 1272.23'.
FOUND 5/8" IRON ROD WITH YELLOW PLASTIC CAP STAMPED LS 951 BEARS S 14°04'04" E, 1635.77'.
FOUND 5/8" IRON ROD WITH YELLOW PLASTIC CAP STAMPED LS 951 BEARS S 19°45'37" W, 1715.63'.
FOUND 5/8" IRON ROD WITH YELLOW PLASTIC CAP STAMPED LS 951 BEARS S 47°59'45" W, 1723.88'.

MONUMENT DETAIL

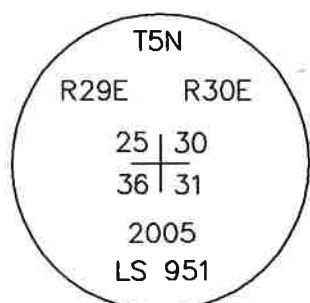

NAD 83/91
OREGON STATE PLANE
INTERNATIONAL FEET

809464.56
8553543.06

MONUMENT SET (PROCEDURES AND DESCRIPTION)

NEW ACCESSORIES FROM WHICH

LOCATION AND COMMENTS

FROM EAST-WEST WALLS ROAD TO WHERE WALLS ROAD ANGLES AND GOES NORTHEAST. GO EAST +/- 1 MILE TO CORNER. CORNER FALLS NORTH-NORTHEAST +/- 330 FEET FROM CENTER OF PIVOT CIRCLE.

FIRM/AGENCY

PRIMM LAND SURVEYING, INC.
P.O. BOX 1322
HERMISTON, OREGON 97838

LAND SURVEYOR

BRIT L. PRIMM

WITNESS

KEITH P. PRIMM

SURVEYOR'S SEAL

REGISTERED
PROFESSIONAL
LAND SURVEYOR

Brit L. Primm
OREGON
JULY 13, 1999
BRIT L. PRIMM
48509

EXPIRATION DATE: 12/31/24