

# OREGON CORNER RESTORATION FORM

SECTION 29, 32 TOWNSHIP 5 NORTH RANGE 29 EAST  
 COUNTY : UMATILLA DATE DEC/22

V-7

CORNER DESIGNATION  
 1/4 CORNER

CONDITION REPORT ONLY  
 NOT FOUND  
 RENEWED  
 UNCOVERED  
 SURVEYED IN  
 REFERENCED


PREVIOUS RENEWALS / SURVEYS, ETC.

SURVEYED IN 1861 BY DAVENPORT UNDER CONTRACT #101, HE SET POST AND MADE MOUND.  
 AS PER LS 951 IN 1979 LAGIER USED A 5/8" IRON ROD REBAR WHICH LIES 30.64 WEST OF CORNER.  
 IN 1989 LS 951 SET A 2 3/8" BRASS CAP.

MONUMENTS AND ACCESSORIES FOUND: CONDITION AND SOURCE

FOUND 2 3/8" BRASS CAP STAMPED AS BELOW.  
 FOUND ALUMINUM TAG IN POWER POLE STAMPED LS 951 BEARS N 32°46' E, 38.51'.  
 FOUND ALUMINUM TAG IN POWER POLE STAMPED LS 951 BEARS S 54°04'01" E, 29.74'.  
 FOUND 5/8" IRON ROD WITH YELLOW PLASTIC CAP STAMPED LS 951 BEARS N 04°12'44" E, 35.57'.  
 FOUND 5/8" IRON ROD WITH YELLOW PLASTIC CAP STAMPED LS 951 BEARS S 68°57'25" W, 45.61'.

MONUMENT DETAIL

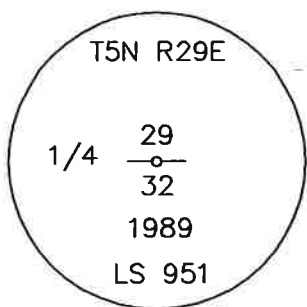

NAD 83/91  
 OREGON STATE PLANE  
 INTERNATIONAL FEET  
 809120.94  
 8529756.06

MONUMENT SET ( PROCEDURES AND DESCRIPTION )

NEW ACCESSORIES FROM WHICH

LOCATION AND COMMENTS

FROM INTERSECTION OF CRAIG ROAD  
 AND WALLS ROAD GO EAST ALONG  
 WALLS ROAD +/-0.5 MILES TO  
 CORNER.

FIRM/AGENCY

PRIMM LAND SURVEYING, INC.  
 P.O. BOX 1322  
 HERMISTON, OREGON 97838

LAND SURVEYOR

BRIT L. PRIMM

WITNESS

KEITH P. PRIMM

SURVEYOR'S SEAL

REGISTERED  
 PROFESSIONAL  
 LAND SURVEYOR

*Brit L. Primm*  
 OREGON  
 JULY 13, 1999  
 BRIT L. PRIMM  
 48509

EXPIRATION DATE: 12/31/24