

OREGON CORNER RESTORATION FORM

SECTION 28, 29, 32, 33 TOWNSHIP 5 NORTH RANGE 29 EAST
COUNTY : UMATILLA DATE DEC/22

V-9

CORNER DESIGNATION
SECTION CORNER

CONDITION REPORT ONLY
 NOT FOUND
 RENEWED
 UNCOVERED
 SURVEYED IN
 REFERENCED

PREVIOUS RENEWALS / SURVEYS, ETC.


SURVEYED IN 1861 BY DAVENPORT UNDER CONTRACT #101, HE SET POST AND MADE MOUND.
IN 1977 LS 951 FOUND A BOLT.
IN 1979 LS 951 SET A RAIL ROAD SPIKE IN PLACE OF MISSING BOLT.

MONUMENTS AND ACCESSORIES FOUND: CONDITION AND SOURCE

FOUND RAIL ROAD SPIKE.
FOUND 2 3/8" BRASS CAP W.C. STAMPED AS BELOW BEARS N 31°45'58" W, 24.42'. DISTURBED
FOUND 5/8" IRON ROD WITH PLASTIC CAP STAMPED LS 951 BEARS N 23°02'36" E, 75.18'.

MONUMENT DETAIL

2 3/8" BRASS CAP W.C.

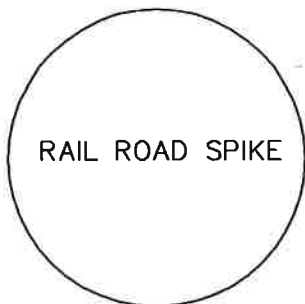


NAD 83/91
OREGON STATE PLANE
INTERNATIONAL FEET

809140.57
8532411.58



N.T.S

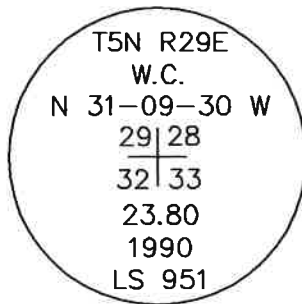

MONUMENT SET (PROCEDURES AND DESCRIPTION)

NEW ACCESSORIES FROM WHICH

SET 5/8" X 30" IRON ROD WITH YELLOW PLASTIC CAP STAMPED PLS LS 48509 BEARS S 79°12'34" E, 82.67'.
SET 5/8" X 30" IRON ROD WITH YELLOW PLASTIC CAP STAMPED PLS LS 48509 BEARS S 16°41'26" E, 91.76'.

LOCATION AND COMMENTS

CORNER FALLS AT INTERSECTION OF
HIGHWAY 207, EDWARDS ROAD AND
WALLS ROAD.

FIRM/AGENCY

PRIMM LAND SURVEYING, INC.
P.O. BOX 1322
HERMISTON, OREGON 97838

LAND SURVEYOR

BRIT L. PRIMM

WITNESS

KEITH P. PRIMM

SURVEYOR'S SEAL

REGISTERED
PROFESSIONAL
LAND SURVEYOR

Brit L. Primm
OREGON
JULY 13, 1999
BRIT L. PRIMM
48509

EXPIRATION DATE: 12/31/24

23-012-C