

# OREGON CORNER RESTORATION FORM

SECTION 34 TOWNSHIP 5 NORTH RANGE 29 EAST

Z-15

COUNTY : UMATILLA DATE DEC/22

CORNER DESIGNATION

1/4 CORNER

CONDITION REPORT ONLY

NOT FOUND

RENEWED

UNCOVERED

SURVEYED IN

REFERENCED

PREVIOUS RENEWALS / SURVEYS, ETC.

SURVEYED IN 1860 BY MAXON AND HURD UNDER CONTRACT #50, THEY SET POST AND MADE MOUND.  
IN 2005 LS 951 SET A 2 3/8" BRASS CAP.

MONUMENTS AND ACCESSORIES FOUND: CONDITION AND SOURCE

FOUND 2 3/8" BRASS CAP STAMPED AS BELOW.


FOUND 5/8" IRON ROD WITH YELLOW PLASTIC CAP STAMPED LS 951 BEARS N 38°26'07" W, 799.59'.

FOUND 5/8" IRON ROD WITH YELLOW PLASTIC CAP STAMPED LS 951 BEARS S 65°59'53" W, 766.68'.

FOUND 5/8" IRON ROD WITH YELLOW PLASTIC CAP STAMPED LS 951 BEARS S 35°45'35" W, 324.85'.

FOUND 5/8" IRON ROD WITH YELLOW PLASTIC CAP STAMPED LS 951 BEARS S 10°49'41" E, 142.73'.

MONUMENT DETAIL

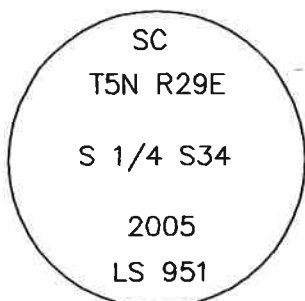

N.T.S

NAD 83/91  
OREGON STATE PLANE  
INTERNATIONAL FEET

803999.59  
8540442.81

MONUMENT SET ( PROCEDURES AND DESCRIPTION )

NEW ACCESSORIES FROM WHICH

LOCATION AND COMMENTS

FROM MOST NORTHEASTERLY  
CORNER ON THE SPILLWAY FOR  
COLD SPRINGS RESERVOIR GO  
NORTH-NORTHEAST +/- 440 FEET  
TO CORNER. CORNER FALLS IN THE  
TREES SURROUNDING COLD SPRINGS  
RESERVOIR.

FIRM/AGENCY

PRIMM LAND SURVEYING, INC.  
P.O. BOX 1322  
HERMISTON, OREGON 97838

LAND SURVEYOR

BRIT L. PRIMM

WITNESS

KEITH P. PRIMM

SURVEYOR'S SEAL

REGISTERED  
PROFESSIONAL  
LAND SURVEYOR

OREGON  
JULY 13, 1999  
BRIT L. PRIMM  
48509

EXPIRATION DATE: 12/31/24