

OREGON CORNER RESTORATION FORM

SECTION 32, 33 TOWNSHIP 5 NORTH RANGE 29 EAST
COUNTY : UMATILLA DATE DEC/22

Z-9

CORNER DESIGNATION

SECTION CORNER

CONDITION REPORT ONLY
 NOT FOUND
 RENEWED
 UNCOVERED
 SURVEYED IN
 REFERENCED


PREVIOUS RENEWALS / SURVEYS, ETC.

SURVEYED IN 1860 BY MAXON AND HURD UNDER CONTRACT #50, THEY SET POST AND MADE MOUND.
IN 1913 KIMBRELL SET 1 2 1/2" IRON PIPE.
IN 1975 STAEBLER DROVE 1 1/2" IRON ROD INSIDE IRON PIPE.
IN 1990 EDWARDS SET A 2 1/2 BRASS CAP OVER IRON ROD, NOT FOUND.

MONUMENTS AND ACCESSORIES FOUND: CONDITION AND SOURCE

FOUND 1/2" IRON ROD.
FOUND ALUMINUM TAG IN RAIL ROAD TIE STAMPED LS 951 BEARS N 48°25'04" E, 47.43'.
FOUND ALUMINUM TAG IN POWER POLE STAMPED LS 951 BEARS S 49°30'29" E, 46.01'.
FOUND 5/8" IRON ROD WITH YELLOW PLASTIC CAP STAMPED LS 951 BEARS S 01°23'45" W, 24.37'.

MONUMENT DETAIL

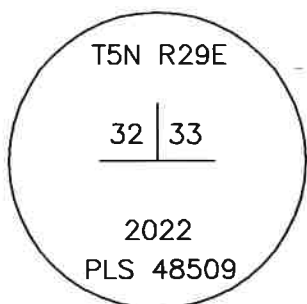

NAD 83/91
OREGON STATE PLANE
INTERNATIONAL FEET

803894.04
8532494.09

MONUMENT SET (PROCEDURES AND DESCRIPTION)

SET 5/8" X 30" IRON ROD (AT LOCATION OF FOUND 1/2" IRON ROD) WITH 2" ALUMINUM CAP STAMPED AS ABOVE.

NEW ACCESSORIES FROM WHICH

SET 5/8" X 30" IRON ROD WITH YELLOW PLASTIC CAP STAMPED PLS LS 48509 BEARS N 19°04'12" W, 61.81'.

LOCATION AND COMMENTS

CORNER FALLS AT THE INTERSECTION
OF NORTH EDWARDS ROAD AND
PUNKIN CENTER ROAD.

FIRM/AGENCY

PRIMM LAND SURVEYING, INC.
P.O. BOX 1322
HERMISTON, OREGON 97838

LAND SURVEYOR

BRIT L. PRIMM

WITNESS

KEITH P. PRIMM

SURVEYOR'S SEAL

REGISTERED
PROFESSIONAL
LAND SURVEYOR

OREGON
JULY 13, 1999
BRIT L. PRIMM
48509

EXPIRATION DATE: 12/31/24