


OREGON COUNTY CORNER RESTORATION FORM

Section 35, 36 Township 5N Range 30E
 County Umatilla Date: 09-07-2006 Condition Report Only
 Corner Designation: 5N30E X21 Not Found
 Remonumented
 Unrecorded
 Surveyed In
 Referenced Out

Previous Renewals / Surveys, etc.
 08-1861 S. Payne - Subdv (100) "Set-charred stake with mound trench and pits as per instrs for corner to secs 25, 26, 35, 36."
 08-1934 ODOT J.A. Phelps (Dwg 5B-1-1) Tie to found "Fc. Cor." of 5N30E T21 to found (V21) "2730.0' to Sec. Cor (Old Fc. Cor.)"
 10-1940 ODOT (Dwg 5B-29-11) "Fc. Cor." corner indicated on map

Monument and Accessories Found: (condition and source)

Searched for and did not find charred stake or fence post.
 Plowed field.

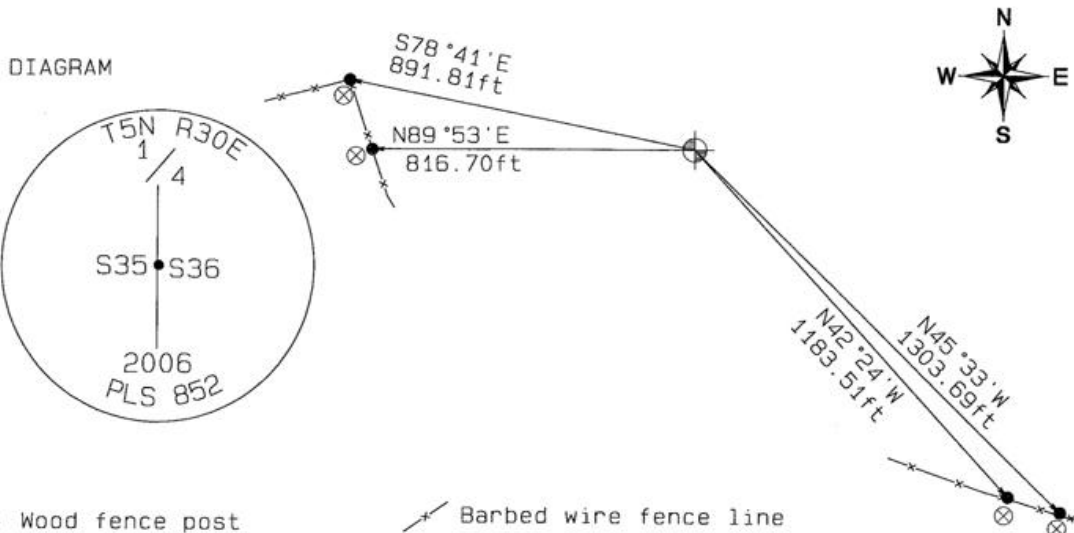

- ⊗ Wood fence post
- ⊕ Set 2-3/8" dia. Brass cap on a 1-1/2" x 30" long Galvanized pipe monument.
- ↗ Barbed wire fence line
- 5/8" dia. x 30" long Iron Rebar with a 1.3" dia. Red plastic cap.

MONUMENT(S) AND ACCESSORIES SET (Procedures and Description)
 Set a 2-3/8" dia. Brass Capped monument (stamped as shown) on a 1-1/4" ID x 30" long galvanized pipe 24" below the ground surface.
 Set a Umatilla County Survey Marker sign 6" West of the Northwest RM facing North.

REFERENCES SET:

Set four (5/8" dia x 30" long Iron rebar with a 1.3" dia. Red plastic cap) to the bearings and distances from monument shown above in the sketch.

Made GPS tie to TRI Stations	Oregon State Plane Coord. - North Zone
LAURILA RESET RB 1379 and	Northing 807159.83
WALLS RB 1396	Easting 8580117.48
Latitude 45°52'15.84058"N	Ortho Height 980.67
Longitude 119°00'57.25126"W	Ellipsoidal Height 911.46
NAD 83(1991)	

Location and Comments Compass Declination Surveyors Seal
 18°E

Beginning 1.5 miles West of HWY 37 and the S. Fork Cold Spring Road. South on Umatilla County Road 1172 (KOSMOS RD) 0.59 miles to a East field access gate. Thence East 0.83 miles to the 1/16th corner. Thence South 0.50 miles to the 1/16th corner. Thence East 0.22 miles to the corner buried 24" below surface.

REGISTERED
 PROFESSIONAL
 LAND SURVEYOR

David L. Haddock

OREGON
 JULY 12, 1968
 DAVID L. HADDOCK
 852

RENEWS 6-30-07

RECEIVED BY:

Firm / Agency

Date 02-07
 Rec'd By: *DHK*
 No.: 07-209-K

Haddock Surveying
 P. O. Box 1574
 Pendleton, OR 97801
 (541) 276-2174