OREGON CORNER RESTORATION FORM

Section 29, 30, 31, 32 Township 5N Range 31E
County Umatilla Date: 08-30-2006

Corner Designation: 5N31E V5

_____	Condition Report Only
___X___	Not Found
_____	Remonumented
_____	Unrecorded
___X___	Surveyed In
___X___	Referenced Out

Previous Renewals / Surveys, etc.

10-1874 N.Walden Subdv (209) "Deposit Basalt Stone 6x4x4 marked with a cross and raise mound of Earth with pits & charcoal as per instructions for Sec. Cor. 29, 30, 31+32. Drove alder stake 2ft long 2in square in S.E. pit.
10-1907 J.Kimbrell Survey #257 Book 2 pg 62 "the corner to Sec 29-30-31&32"
08-1934 ODOT J.A. Phelps (Dwg 5B-1-1) Angle and distances from intersection of Hwy 37 and N-S section line to 1/4 corner then to Corner.
10-1940 ODOT (Dwg 5B-29-11) "Found" and corner indicated on map

Monument and Accessories Found: (condition and source)
Searched for and did not find stone. Found glass mason jar, many steel items, bobwire at corner location. Found wire line from South to point

DIAGRAM

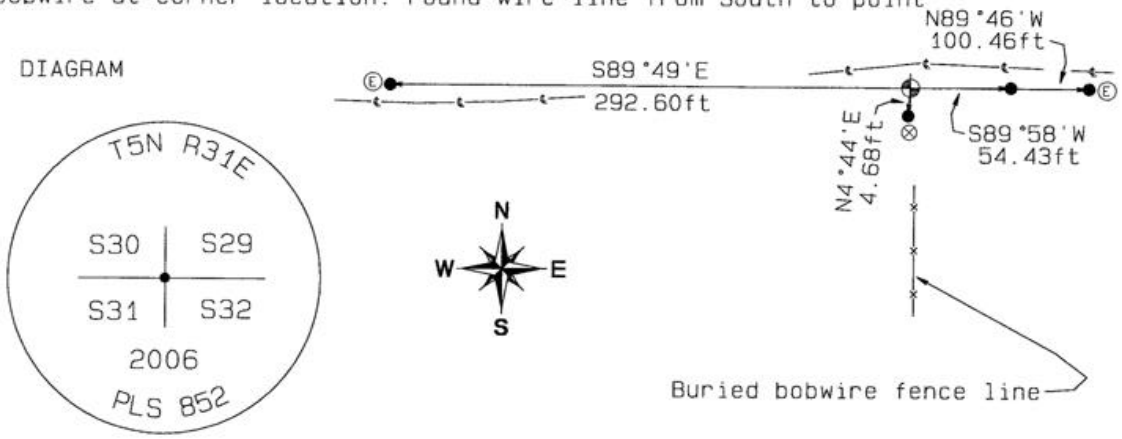

Field access road

5/8"dia. x 30" long Iron Rebar with a 1.3"dia. Red plastic cap.

Set 2-3/8"dia. Brass cap on a 1-1/2" x 30" long Galvanized pipe monument.

10"dia. Wood power pole

Wood fence post

MONUMENT(S) AND ACCESSORIES SET (Procedures and Description)
Set a 2-3/8"dia.Brass Capped monument (stamped as shown) on a 1-1/4"ID x 30"long galvanized pipe 6" below the ground surface.
Set a Umatilla County Survey Marker sign facing West along the field access road.

REFERENCES SET:

Set four (5/8" dia x 30" long Iron rebar with a 1.3" dia. Red plastic cap) to the bearings and distances from monument shown above in the sketch.

Made GPS tie to TRI Stations
LAURILA RESET RB 1379 and
WALLS RB 1396
Latitude 45 °52'41.58870"N
Longitude 118°58'28.72984"W
NAD 83(1991)

Oregon State Plane Coord. - North Zone
Northing 809961.11
Easting 8590581.50
Ortho Height 1159.52
Ellipsoidal Height 1090.52

Location and Comments

Compass Declination
18°E

Proceed from the junction of HWY 37 and South Cold Springs Highway Southeast on S. Cold Springs Hwy (Umatilla County Rd # 850) approximately 1.0 miles to a West field access road. Thence 0.56 miles West to the corner.

Surveyors Seal

REGISTERED
PROFESSIONAL
LAND SURVEYOR

David L. Haddock

OREGON
JULY 12, 1968
DAVID L. HADDOCK
852

RENEWS 6-30-07

RECEIVED BY:

Date 02-07
Rec'd By: OHC
No.: 07-211-R

Firm / Agency

Haddock Surveying
P. O. Box 1574
Pendleton, OR 97801
(541) 276-2174