

OREGON CORNER RESTORATION FORM

COUNTY: Umatilla. DATE: 11/21/23.

CORNER DESIGNATION: R-17, the Northwest corner of Section 26, Township 5 North, Range 33 East, W.M.

PREVIOUS RENEWALS/SURVEYS ETC: Corner was originally established by Odell and Lewis, Deputy Surveyors under Contract No. 110, dated February 7, 1865. Original notes state: "Set post corner for Secs 22, 23, 26 & 27. Drove charred stake. Dug pits and raised mound as per instructions". No record of subsequent re-monumentation was found in county records.

MONUMENT AND ACCESSORIES FOUND: None. I held the intersection of field berms North-South and East as best remaining evidence of the original corner location. The corner area is farmed throughout the corner area.

MONUMENT MARKING DETAIL:

T5N R33E
S22|S23

S27|S26
2023
PLS 1106

NEW CORNER MONUMENT SET: At the intersection of field berms described above, set a 2 1/2 inch brass cap on 1 1/4 inch galvanized iron pipe with brass cap 24 inches below ground line. Placed a "witness" sign below ground beside the corner monument. The brass cap is marked as shown in "Monument Marking Detail".

New accessories set:

- A silver "deep 1" magnet, buried 20 inches below ground line, bears N 32°25'25" East, 21.87 feet, with bearing object sign alongside, below ground.
- A pink "deep 1" magnet, buried 20 inches below ground line, bears S 36°17'51" East, 25.86 feet, with bearing object sign alongside, below ground.
- A blue "deep 1" magnet, buried 20 inches below ground line, bears S 49°54'35" East, 26.45 feet, with bearing object sign alongside, below ground.
- A orange "deep 1" magnet, buried 20 inches below ground line, bears N 45°57'37" West, 24.80 feet, with bearing object sign alongside, below ground.

The corner monument and all accessories are all buried below ground as the corner area is completely farmed over.

Bearings to corner accessories are State Plane Grid bearings and distances.

LOCATION AND COMMENTS: Corner Monument falls in the intersection of field berms North-South and East. Map reference for additional information: Partition Plat No. 2023-19.

OREGON STATE PLANE COORDINATE, North Zone NAD 83(2011) epoch 2010.00, International Feet
Units:


N: 816620.45
E: 8670097.71

FIRM: Wells Surveying

Surveyor's Seal

P.O. Box 1696
Pendleton, OR 97801

15N33R-17

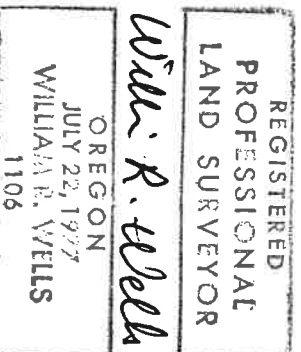

Renews: 6-30-24

24-008-R