

OREGON CORNER RESTORATION FORM

Section 19 Township 5N
County Umatilla Date: 01/15/10

Range 35E

Corner Designation: 5N35P3

Corner common to section 19 T5NR35E

_____	Condition Report Only
<u> X </u>	Not Found
_____	Remonumented
_____	Unrecorded
<u> X </u>	Surveyed In
<u> X </u>	Referenced Out

Previous Renewals / Surveys, etc.

Surveyed by Wm. H. Odell & Wm. S. Lewis under Contract No. 110, dated February 7th 1865.


Monuments and Accessories Found: (Condition and Source)

None.

Diagram



Sketch

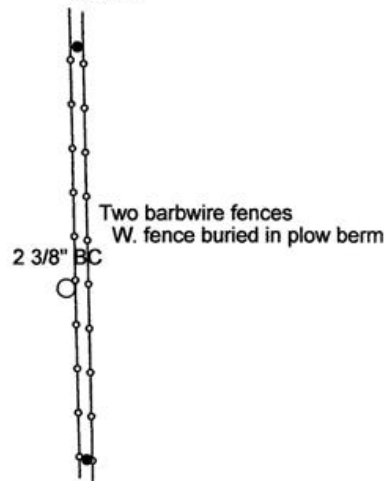

NAD 83/91
OREGON STATE PLANE NORTH
INTERNATIONAL FEET

N819555.16
E8714900.46
LAT - 45° 53' 49.377725" N
LON - 118° 29' 08.60189" W

Monument (s) Set (Procedures and Description)

Set a 1 1/2" Galvanized Iron pipe w/ a 2 1/2" Brass Cap Stamped as shown.
A magnet 24" deep lies N 29°30' W, 13.04'.
A 5/8"x30" Iron rebar w/ypc #43406 lies N 8° E, 25.47'.
A 5/8"x30" Iron rebar w/ypc #43406 lies S 11°45' E, 17.72'.
A magnet 24" deep lies S 44° W, 14.85'.

References Set:

None

Location and Comments

Cor. is in ancient N-S fence at steep Easterly slope into Pine Creek.

Compass Declination
17° E

Surveyors Seal

REGISTERED
PROFESSIONAL
LAND SURVEYOR

Robert D. English
OREGON
JANUARY 11, 2005
ROBERT DOUGLAS ENGLISH
43406LS

RENEWAL DATE: 12/31/11

RECEIVED BY:

Date: 12-08
Rec'd By: _____
No. 09-176-B

Firm / Agency

Survey One, LLC.
P.O. Box 382
Pendleton, OR 97801
(541) 276-2055