

OREGON CORNER RESTORATION FORM

Section 1 Township 5N Range 36E
 County Umatilla Date: May 15, 2012

Corner Designation: 5N36C21

Condition Report Only
 Not found

Quarter corner common to sections 1 and 2, T5N, R36E,
 W.M., Umatilla County, Oregon.


Remonumented
 Unrecorded
 Surveyed in
 Referenced out

Previous Renewals / Surveys, etc.


Corner was originally set by Odell and Lewis under contract No. 110 dated February 7, 1865.
 Their record reads: Set 1/4 Sec. post. Drove charred stake, dug pits and raised mound as
 per instructions.

Monument and Accessories found: (condition and source)
 None. This point falls in a plowed field.

DIAGRAM

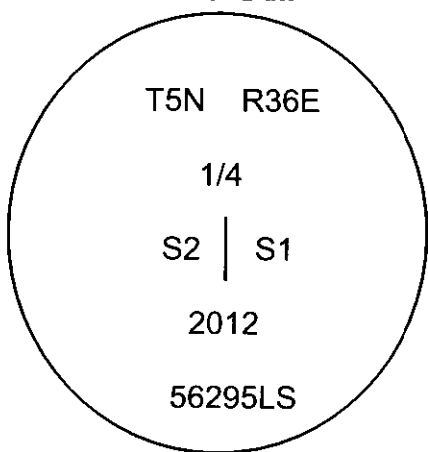

SKETCH
 N.T.S.

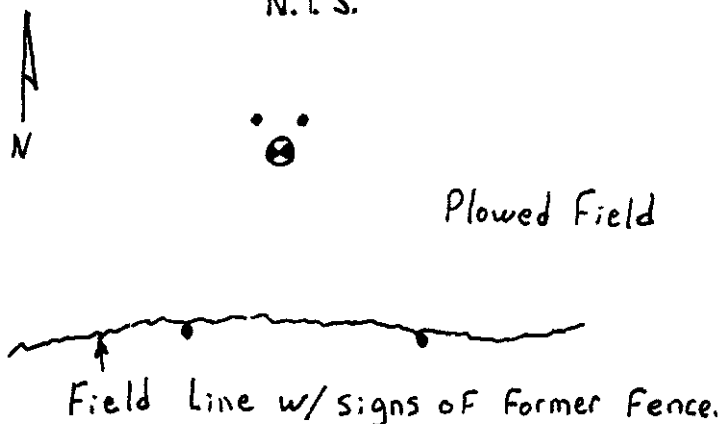

- ⊗ = Brass cap
- = Rebar Reference

MONUMENT (S) AND ACCESSORIES SET (Procedures and Description)

Set a 1 1/2" x 30" galvanized iron pipe with a 2 3/8" brass cap stamped as shown in the diagram
 above 2 feet below the surface of the plowed field at the proportionate point.

For references, I set four 5/8" by 24" iron rebars with 1 1/8" orange plastic caps stamped WTS
 and 56295LS as described below 2 feet below the surface of the plowed field:
 an iron rebar bears N62°48'47"W, 24.09 feet;
 an iron rebar bears N33°22'28"E, 23.58 feet;
 an iron rebar bears S24°28'09"E, 275.88 feet in the existing field line;
 an iron rebar bears S19°18'38"W, 281.91 feet in the existing field line;

The monument was set and references were tied using Trimble R7/R8 RTK GPS.

Location and comments
 NAD 83/1991 State Plane Coordinate
 Oregon North Zone
 N = 836913.14 ift
 E = 8769980.14 ift

Compass Declination

Surveyors Seal

RECEIVED BY:
 Umatilla County Surveyor
 Date: 6/5/2012
 Rec'd By: S. Res
 No. 12-088-C

Firm / Agency
 Witness Tree Surveying
 Address
 P.O. Box G
 Pilot Rock, Or. 97868
 Party Chief
 Stephen K, Haddock

REGISTERED
 PROFESSIONAL
 LAND SURVEYOR

Stephen K. Haddock

OREGON
 JULY 9, 2001
 STEPHEN K. HADDOCK
 56295LS

RENEWAL DATE 6-30-13