

**OREGON CORNER RESTORATION FORM**

Section 4 Township 5N Range 36E  
 County Umatilla Date: June 28, 2012


Corner Designation: 5N36C9

Condition Report Only  
 Not found  
 Remonumented  
 Unrecorded  
 Surveyed in  
 Referenced out

Quarter corner common to sections 4 and 5, T5N, R36E,  
 W.M., Umatilla County, Oregon.

Previous Renewals / Surveys, etc.  
 Corner was originally set by Odell and Lewis under contract No. 110 dated February 7, 1865.  
 Their record reads: Set 1/4 Sec. post. Drove charred stake, dug pits and raised mound as  
 per instructions. In the record of private surveys Book , Page 393, John Kimbrell reports  
 crossing a new wire fence near this point.

Monument and Accessories found: ( condition and source )  
 The intersection of field berms running east, west, and north.

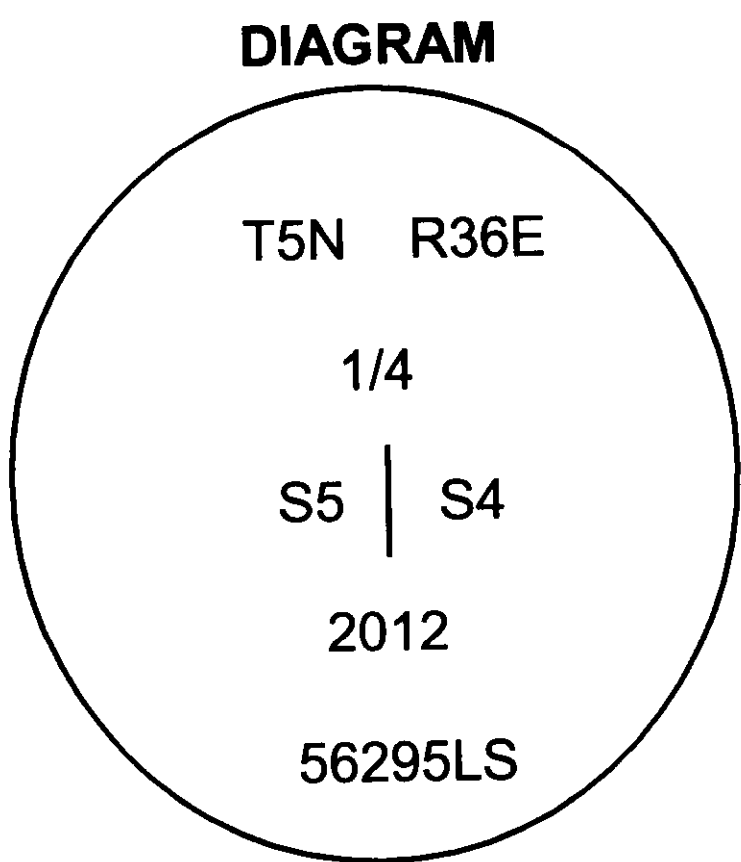

- O = Brass Cap
- = Rebar Reference

**MONUMENT (S) AND ACCESSORIES SET (Procedures and Description)**  
 Set a 1 1/2" x 30" galvanized iron pipe with a 2 3/8" brass cap stamped as shown in the diagram  
 above 2 feet below the surface of the plowed field at the intersection of the field lines.

For references, I set four 5/8" by 24" iron rebars with 1 1/8" orange plastic caps stamped WTS  
 and 56295LS as described below 2 feet below the surface of the field lines:  
 an iron rebar bears N89°12'05"W, 30.94 feet;  
 an iron rebar bears N86°41'29"E, 26.46 feet;  
 an iron rebar bears N1°26'20"E, 12.90 feet;  
 an iron rebar bears N1°34'22"W, 32.92 feet;

The monument and references were tied using a Trimble R7/R8 RTK GPS.

Location and comments  
 NAD 83/1991 State Plane Coordinate  
 Oregon North Zone  
 N = 836278.08 ift  
 E = 8754286.47 ift

Compass Declination

Surveyors Seal

RECEIVED BY:  
 Umatilla County Surveyor  
 Date: 12/6/2012  
 Rec'd By: S. Oles  
 No. 12-155-B

Firm / Agency  
 Witness Tree Surveying  
 Address  
 P.O. Box G  
 Pilot Rock, Or. 97868  
 Party Chief  
 Stephen K, Haddock

REGISTERED  
 PROFESSIONAL  
 LAND SURVEYOR

*Stephen K. Haddock*

OREGON  
 JULY 9, 2001  
 STEPHEN K. HADDOCK  
 56295LS

RENEWAL DATE 6-30-13