

OREGON CORNER RESTORATION FORM

Section 7 Township 5N Range 36E
 County Umatilla Date: September 25, 2012

Corner Designation: 5N36G5

Condition Report Only
 Not found
 Remonumented
 Unrecorded
 Surveyed in
 Referenced out


Quarter corner common to sections 7 and 8, T5N, R36E,
 W.M., Umatilla County, Oregon.

Previous Renewals / Surveys, etc.


Corner was originally set by Odell and Lewis under contract No. 110 dated February 7, 1865.
 Their record reads: Set 1/4 Sec. post. Drove charred stake, dug pits and raised mound as
 per instructions.

Monument and Accessories found: (condition and source)

Remains of a decayed wooden post at the intersection of field lines to the north, south and east.

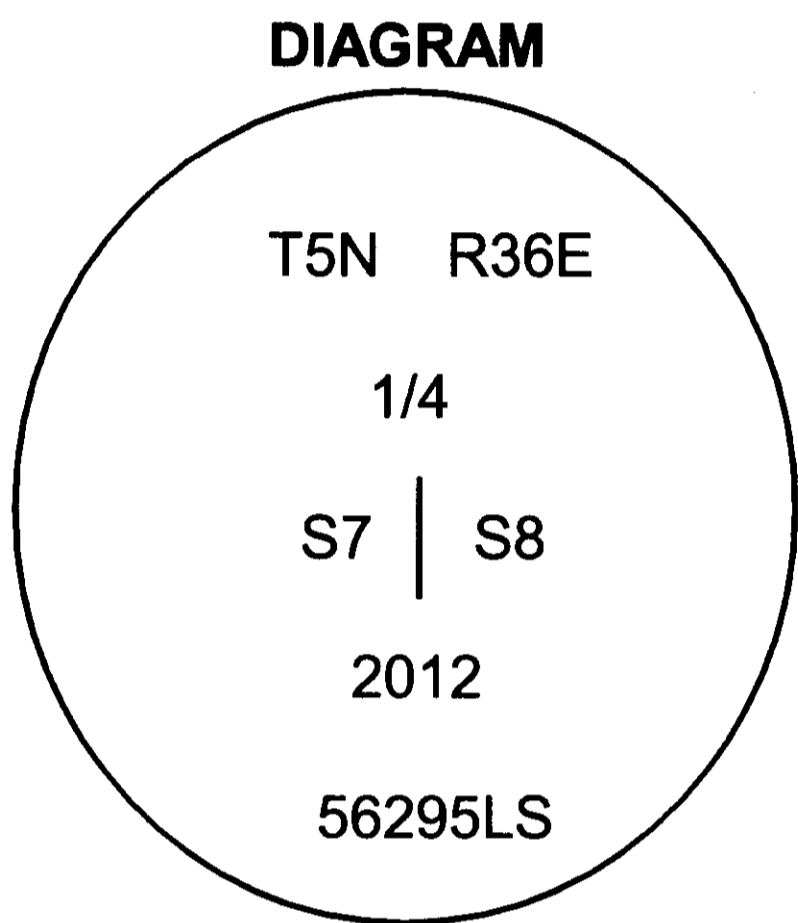

⊗ = Brass Cap
 ● = Rebar Reference

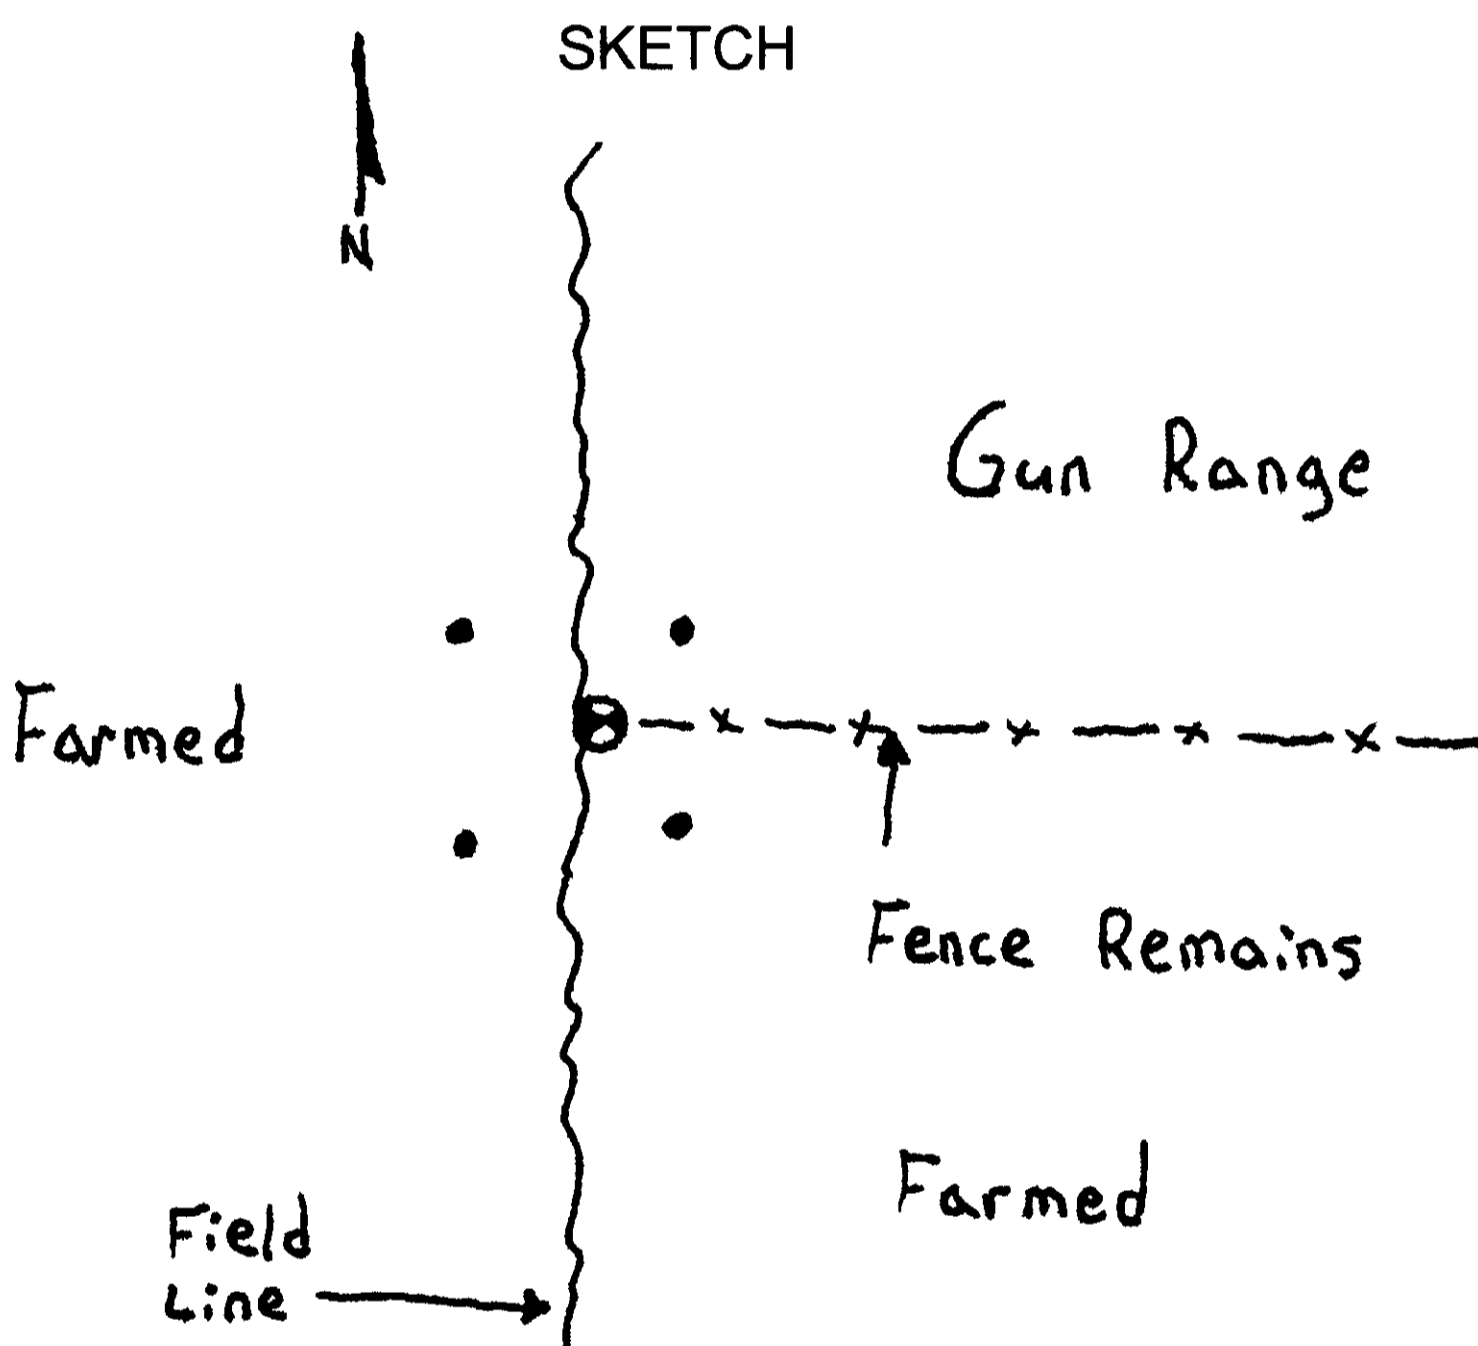

MONUMENT (S) AND ACCESSORIES SET (Procedures and Description)

Set a 1 1/2" x 30" galvanized iron pipe with a 2 3/8" brass cap stamped as shown in the diagram
 above 2 feet below the surface at the position of the decayed wood.

For references, I set four 5/8" by 24" iron rebars with 1 1/8" orange plastic caps stamped WTS
 and 56295LS as described below 2 feet below the surface:

- an iron rebar bears N44°42'43"W, 22.82 feet;
- an iron rebar bears N42°55'53"E, 25.75 feet;
- an iron rebar bears S44°10'06"E, 28.70 feet;
- an iron rebar bears S43°14'58"W, 24.20 feet;

The monument and references were tied using Trimble R7/R8 RTK GPS.

Location and comments
 NAD 83/1991 State Plane Coordinate
 Oregon North Zone
 N = 830631.65 ift
 E = 8748748.89 ift

Compass Declination

Surveyors Seal

RECEIVED BY:
 Umatilla County Surveyor
 Date: 12/6/2012
 Rec'd By: [Signature]
 No. 12-155-B

Firm / Agency
 Witness Tree Surveying
 Address
 P.O. Box G
 Pilot Rock, Or. 97868
 Party Chief
 Stephen K, Haddock

REGISTERED
 PROFESSIONAL
 LAND SURVEYOR

[Signature: Stephen K. Haddock]

OREGON
 JULY 9, 2001
 STEPHEN K. HADDOCK
 56295LS

RENEWAL DATE 6-30-13