

**OREGON CORNER RESTORATION FORM**

Section 14 Township 5N Range 36E  
 County Umatilla Date: March 3, 2012

Corner Designation: 5N36J21

Corner common to sections 11, 12, 13, and 14,  
 T5N, R36E, W.M., Umatilla County, Oregon.


Previous Renewals / Surveys, etc.

Corner was originally set by Odell and Lewis under contract No. 110 dated February 7, 1865.  
 Their record reads: Set post cor., near summit on hill, on side facing W. and N., for secs. 11, 12,  
 13, & 14. Drove charred stake, dug pits, raised mound, as per instructions.

Monument and Accessories found: ( condition and source )  
 None. The point falls in a farmed field on the NW side of a small hill.

Condition Report Only  
 Not found  
 x Remonumented  
 Unrecorded  
 x Surveyed in  
 x Referenced out

**DIAGRAM**

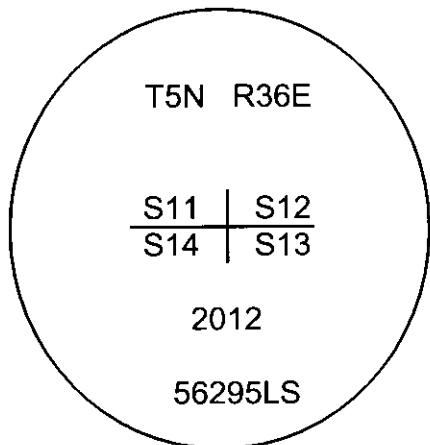

⊙ = Brass cap.  
 ● = Rebar reference.

**SKETCH**



**MONUMENT (S) AND ACCESSORIES SET (Procedures and Description)**

I set a 2 3/8" brass cap on a 1 1/2"x30" galvanized iron pipe with a brass cap stamped as shown in the diagram above 2 feet below the surface of the field. The corner point was determined by projecting fence and field lines from the E. and W. for latitude and proportioning the departure.

For references: I set 4, 5/8"x24" iron rebars with orange plastic caps stamped WTS and 56295LS as described below 2 feet below the surface of the field:

- An iron rebar bears N43°56'07"W, 26.51 feet;
- An iron rebar bears N53°55'06"E, 24.31 feet;
- An iron rebar bears S59°17'36"W, 24.87 feet;
- An iron rebar bears S36°15'57"E, 26.08 feet;

The monument and references were tied using a Trimble R7/R8 RTK GPS system.

Location and comments  
 NAD 83/1991 State Plane Coordinate  
 Oregon North Zone  
 N = 829002.48 ift  
 E = 8769926.61 ift

Compass Declination  
 Firm / Agency  
 Witness Tree Surveying  
 Address  
 P.O. Box G  
 Pilot Rock, Or. 97868  
 Party Chief  
 Stephen K, Haddock

Surveyors Seal

RECEIVED BY:  
 Umatilla County Surveyor  
 Date: 6/5/2012  
 Rec'd By: A. Res  
 No. 12-088-C

**REGISTERED  
 PROFESSIONAL  
 LAND SURVEYOR**

*Stephen K. Haddock*

**OREGON  
 JULY 9, 2001  
 STEPHEN K. HADDOCK  
 56295LS**

**RENEWAL DATE 6-30-13**