

OREGON CORNER RESTORATION FORM

Section 12 Township 5N Range 36E
 County Umatilla Date: May 12, 2012

Corner Designation: 5N36J23

Condition Report Only
 Not found
 Remonumented
 Unrecorded
 Surveyed in
 Referenced out


Quarter corner common to sections 12 and 13,
 T5N, R36E, W.M., Umatilla County, Oregon.

Previous Renewals / Surveys, etc.

Corner originally set by Odell and Lewis under contract No. 110 dated February 7, 1865. Their record reads: Set 1/4 Sec. post, drove charred stake, dug pits and raised mound as per instructions.


Monument and Accessories found: (condition and source)
 None. The point falls in an E-W field line

DIAGRAM

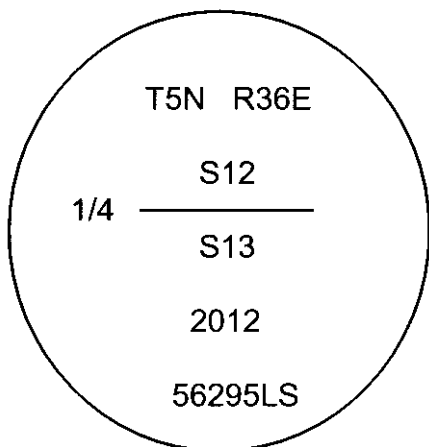

- ⊗ = Brass cap.
- = 1" Iron Rebar
- = Steel guard post
- x = Rebar reference.

SKETCH
 N. T. S.

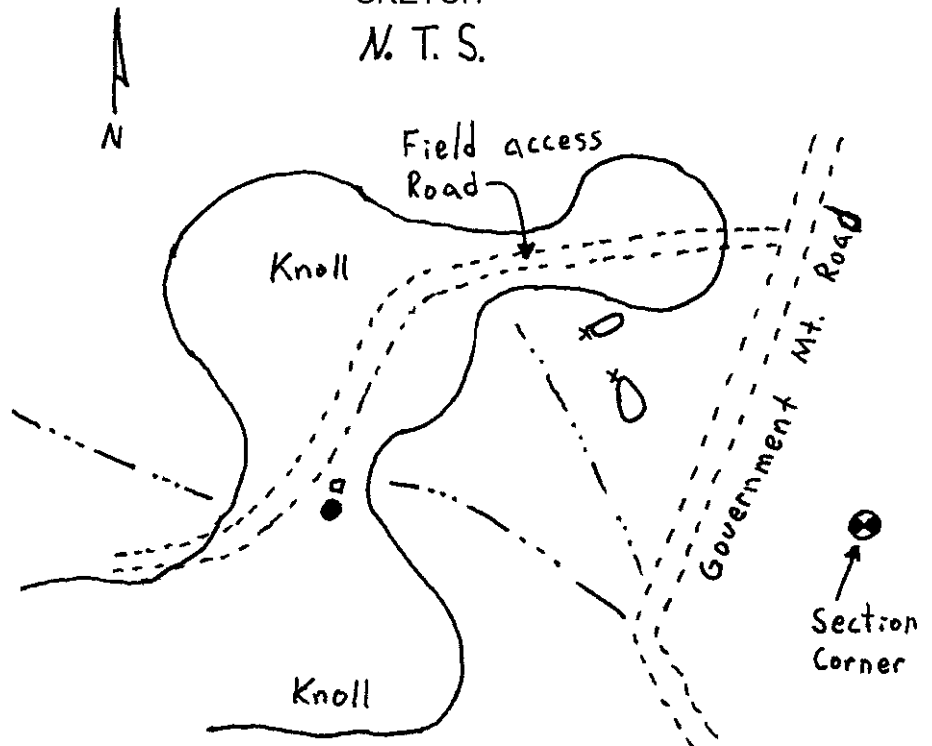

MONUMENT (S) AND ACCESSORIES SET (Procedures and Description)

At the proportionate point I set a 1" x 24" iron rebar with a 2" aluminum cap stamped as shown in the diagram above 24" in the ground to bedrock.

There being only a few inches of soil at this location, it was not practical to set references nearby given their liklihood of being farmed out. For references I set two 5/8" x 24" iron rebars with 1 1/4" orange plastic caps stamped WTS and 56295LS as described below:

- an iron rebar bears N42°56'04"E, 1194.20 feet, in a mound of field stones;
- an iron rebar bears N58°43'22"E, 1072.23 feet in a mound of field stones;
- the brass cap at the SE corner of Section 12 is in plain sight and bears N89°25'52"E 2679.45';

The monument was set and references tied using a Trimble R7/R8 RTK GPS system.

Location and comments
 NAD 83/1991 State Plane Coordinate
 Oregon North Zone
 N = 829102.48 ift
 E = 8772603.92 ift

Compass Declination

Surveyors Seal

RECEIVED BY:
 Umatilla County Surveyor
 Date: 6/5/2012
 Rec'd By: S. Owe
 No. 12-088-C

Firm / Agency
 Witness Tree Surveying
 Address
 P.O. Box G
 Pilot Rock, Or. 97868
 Party Chief
 Stephen K, Haddock

REGISTERED PROFESSIONAL LAND SURVEYOR
Stephen K. Haddock
OREGON
 JULY 9, 2001
 STEPHEN K. HADDOCK
 56295LS
 RENEWAL DATE 6-30-13