

OREGON CORNER RESTORATION FORM

Section 8 Township 5N Range 36E
 County Umatilla Date: August 16, 2012

Corner Designation: 5N36J9

Condition Report Only
 Not found
 Remonumented
 Unrecorded
 Surveyed in
 Referenced out

 T5N, R36E, W.M., Umatilla County, Oregon.


Previous Renewals / Surveys, etc.

Corner was originally set by Odell and Lewis under contract No. 110 dated February 7, 1865. Their record reads: Set post corner for secs. 7, 8, 17 and 18. Drove charred stake, dug pits, raised mound, as per instructions. In the record of private surveys Book 1, Page 404, John Kimbrell reports surveying to this corner.

Monument and Accessories found: (condition and source)

A basalt stone 12x8x6 ins. burried in an east - west field line. (Presumably by Kimbrell)


DIAGRAM

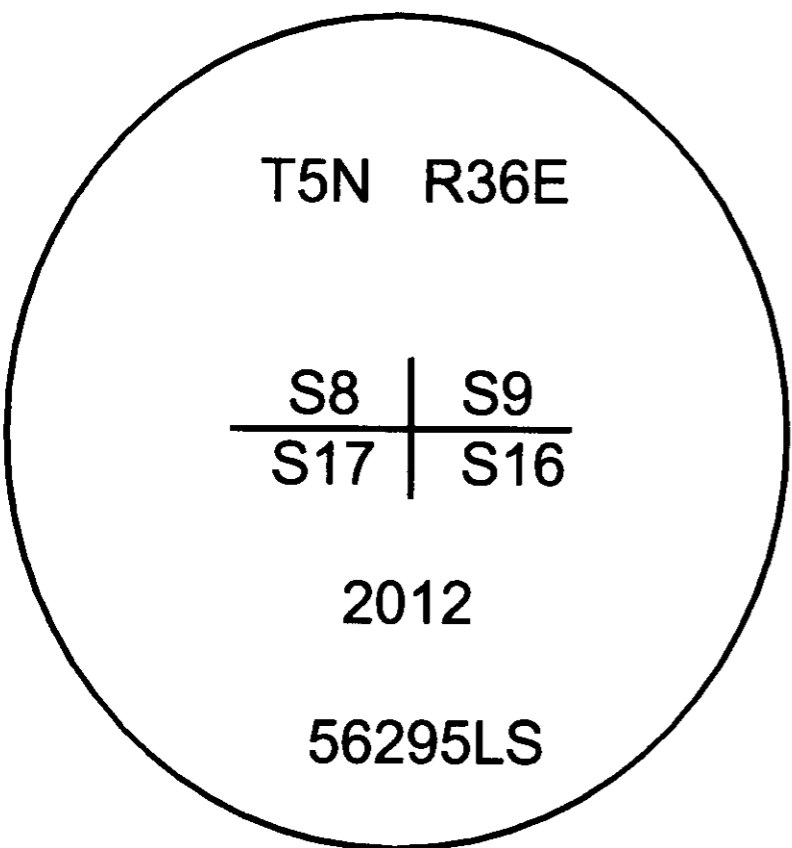

⊙ = Brass Cap

● = Rebar Reference

SKETCH

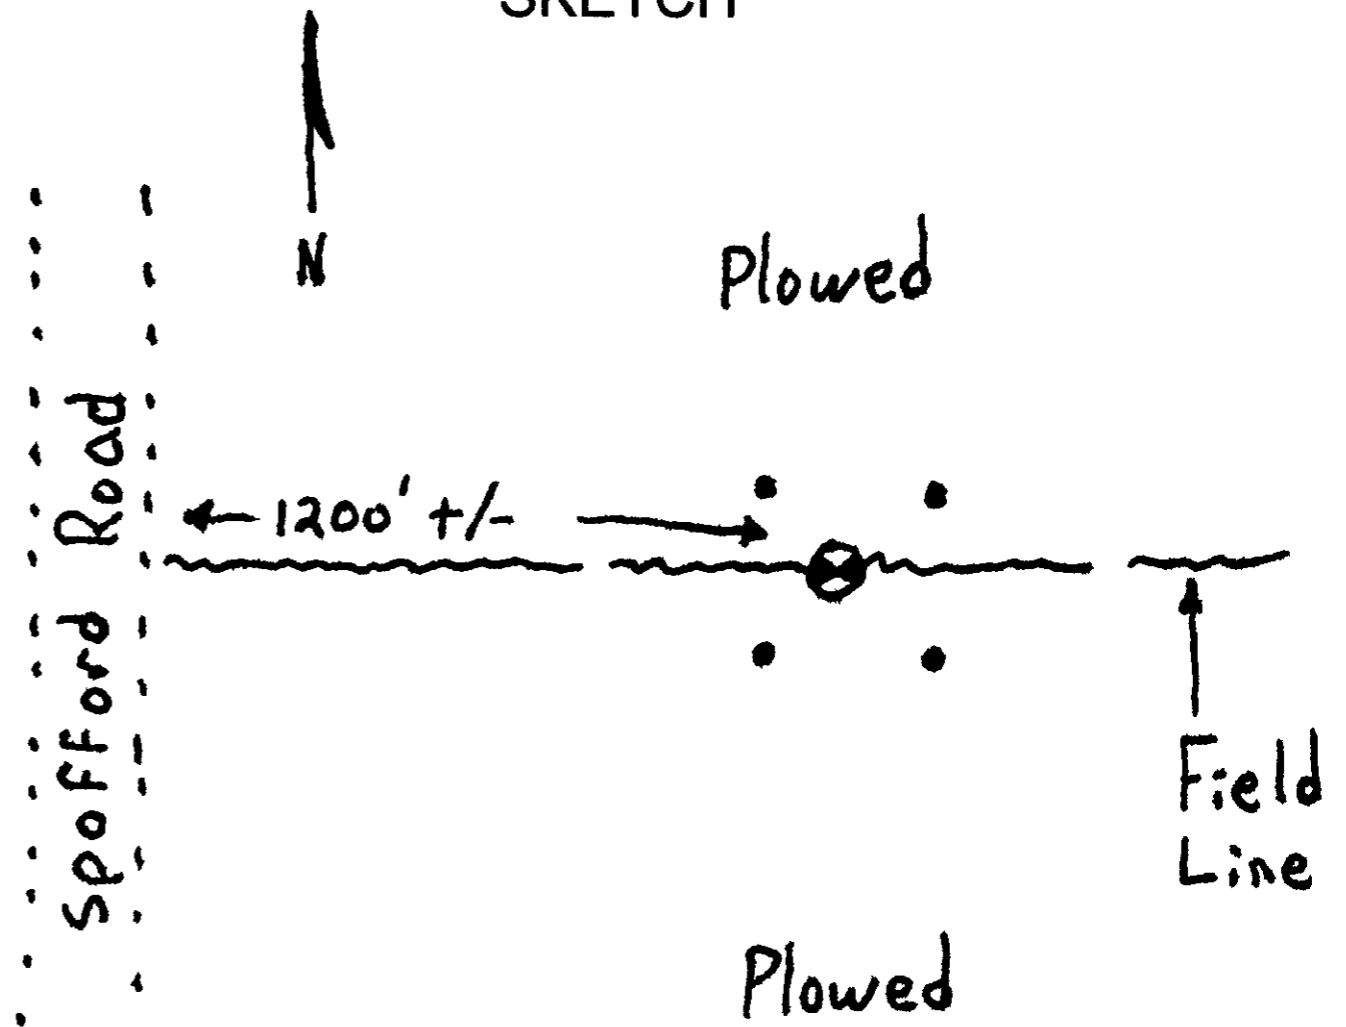

MONUMENT (S) AND ACCESSORIES SET (Procedures and Description)

I set a 2 3/8" brass cap on a 1 1/2"x30" galvanized iron pipe with a brass cap stamped as shown in the diagram above at the position of the found stone 20" below the surface.

For references: I set 4, 5/8"x24" iron rebars with orange plastic caps stamped WTS and 56295LS as described below 20 inches below the surface of the ground:

- An iron rebar bears N54°21'34"W, 30.60 feet;
- An iron rebar bears N46°18'57"E, 28.79 feet;
- An iron rebar bears S52°48'01"E, 27.40 feet;
- An iron rebar bears S44°49'48"W, 26.85 feet;

The monument and references were tied using a Trimble R7/R8 RTK GPS system.

Location and comments

NAD 83/1991 State Plane Coordinate
 Oregon North Zone
 N = 828282.43 ift
 E = 8754550.83 ift

Compass Declination

Firm / Agency
 Witness Tree Surveying
 Address
 P.O. Box G
 Pilot Rock, Or. 97868
 Party Chief
 Stephen K, Haddock

Surveyors Seal

REGISTERED
 PROFESSIONAL
 LAND SURVEYOR

Stephen K. Haddock

OREGON
 JULY 9, 2001
 STEPHEN K. HADDOCK
 56295LS

RENEWAL DATE 6-30-13

RECEIVED BY:

Umatilla County Surveyor
 Date: 12/6/2012
 Rec'd By: [Signature]
 No. 12-155-B