

OREGON CORNER RESTORATION FORM

Section 14 Township 5N Range 36E
 County Umatilla Date: February 18, 2012

Corner Designation: 5N36L21

Condition Report Only
 Not found
 Remonumented
 Unrecorded
 Surveyed in
 Referenced out

Quarter corner common to sections 13 and 14, T5N, R36E, W.M., Umatilla County, Oregon.


Previous Renewals / Surveys, etc.

Corner was originally set by Odell and Lewis under contract No. 110 dated February 7, 1865. Their record reads: Set 1/4 Sec. post on steep hillside.

Monument and Accessories found: (condition and source)


I held the intersection of the N-S section line and a line projected from the plow berm to the west.

DIAGRAM

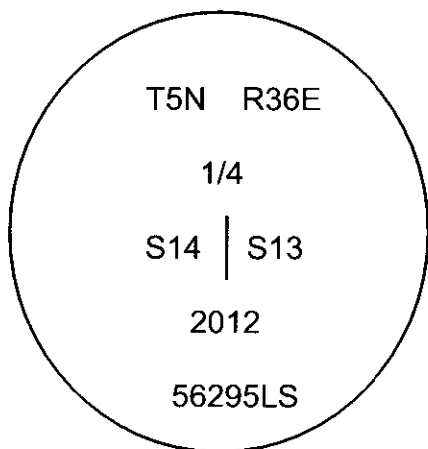

- ⊙ = Brass cap.
- = Rebar reference.

SKETCH

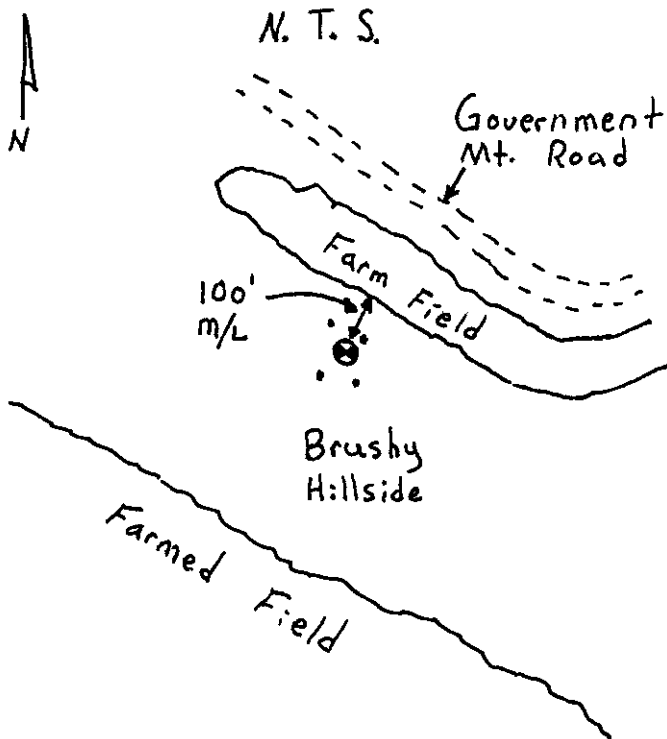

MONUMENT (S) AND ACCESSORIES SET (Procedures and Description)

Set a 1 1/2" x 30" galvanized iron pipe with a 2 3/8" brass cap stamped as shown in the diagram above at the corner point

For references, I set four 5/8" by 24" iron rebars with 1 1/8" orange plastic caps stamped WTS and 56295LS as described below:

- an iron rebar bears N33°58'52"E, 15.69 feet;
- an iron rebar bears S13°31'29"E, 30.06 feet;
- an iron rebar bears S68°42'31"W, 36.11 feet;
- an iron rebar bears N38°15'12"W, 34.92 feet;

The monument was set and references were tied using Trimble R7/R8 RTK GPS.

Location and comments

Compass Declination

Surveyors Seal

NAD 83/1991 State Plane Coordinate

Oregon North Zone

N = 826401.48 ift

E = 8770013.32 ift

Firm / Agency

Witness Tree Surveying

Address

P.O. Box G

Pilot Rock, Or. 97868

Party Chief

Stephen K, Haddock

REGISTERED
 PROFESSIONAL
 LAND SURVEYOR

Stephen K. Haddock

OREGON
 JULY 9, 2001
 STEPHEN K. HADDOCK
 56295LS

RENEWAL DATE 6-30-13

RECEIVED BY:

Umatilla County Surveyor

Date: 6/5/2012

Rec'd By: S. Res

No. 12-088-C