

## OREGON CORNER RESTORATION FORM

COUNTY: Umatilla      DATE: 06/25/2014

**CORNER DESIGNATION:** Z-23, Quarter Corner for Section 36, Township 6 North, Range 37E, and Section 1, Township 5 North, Range 37E, W.M.

### PREVIOUS RENEWALS/SURVEYS ETC:

Originally surveyed by William H. Odell and William S. Lewis, Deputy Surveyors, Contract No. 110, dated February 7, 1865. Their notes state "Set ¼ Section post corner from which:  
A Fir 20 inch diameter bears S. 54° 30'E, 20 links distance.  
A Willow 5 inch diameter bears N. 18° W, 80 links distance.

Surveyor Paul W.P. Tomkins in his August 10, 1992 survey, shown on Umatilla County Survey record of surveys 92-106-C, shows this quarter corner but doesn't report what was found.

Surveyor Paul W.P. Tomkins in his August 26, 1992 Certified Record of Land Corner Monumentation, shown on Umatilla County Survey record of surveys 92-106-C notes: "One-Quarter corner common to Section 36, Township 6N, Range 37 East, and Section 1, Township 5 North, Range 37 East, all in the Willamette Meridian, Umatilla County, Oregon.

History of the original corner establishment:

GLO, William H. Odell and William S. Lewis, Deputy Surveyors Contract No. 110, dated 07 February, 1865.

"Set ¼ Section post corner from which;

A Fir 20 in. dia., bears S54°30'E, 20 lks. Dist.

A Willow 5 in. dia., bears N18°W, 80 lks. dist."

Bert W. Udell, Sept. 11, 1956, "I have had occasion to locate and re-witness the following corner in T 6 N, Range 37 East, W.M. in Umatilla County:

S ¼ Cor. Section 36, T 6 N, R 37 EL

20" Fir S54°E, 15.2 ft. - Now dead - 29". We cut out to scribe.

5" Willow N9°W, 19.8 ft. Old stub, no proof. I scribed 16" Fir on North side for ¼ corner "¼"

"¼" and witnessed it by scribing:


10" Fir N6°W 15.8 ft. "1/4S" "BT" signed Howard E. Taylor"

Gregory A. Crites, Registered Professional Land Surveyor, Ore. No. 1887 & Paul W.P. Tomkins, Registered Professional Land Surveyor, Ore. No. 2360, July 6, 1993:

We found the 16" dia. Fir marked for ¼ corner by Udell lying on the ground with marks plainly evident. A "Walla Walla Lumber Company" Yellow Metal Location Poster is affixed to this tree.

The 10" dia. Grand Fir, N

The original 20" diam. Fir S54°E 15.2 ft. is now a rotten stump with no marks evident."

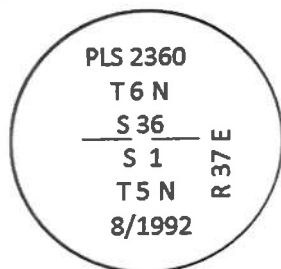

Description of monument and accessories: I established to perpetuate the original location of this corner:

At the record bearing and distance from the Udell bearing tree N6°W 15.8 ft., I set a standard 1" dia. Hoffland galvanized iron pipe with 2-½" bronze cap marked as shown from which, the top

sticking 6 inches out of the ground, in the center of the stump remains of the 16" dia. Grand Fir Bert Udell marked for the ¼ corner, from which:

An 11-½ in. dia. Engel Spruce bears N44°50'W, a distance of 18.25 feet to center, with face mkd. "T6NR37E1/4S36BT" I set an aluminum nail in ¾ in. brass washer mkd. "WA 25895 OR 2360" driven into the center of the "B" scribed on face, which is typical for all bearing trees established in this re-witness.

An 18 in. dia. Grand Fir bears N56°15'E, a distance of 30.7 feet to center, with face mkd. "T6NR37E1/4S36BT."

A 22-½ in. dia. Grand Fir bears S72°30'E, a distance of 34.2 feet to center, with face mkd. T5NR37E1/4S1BT."

A 15 in. dia. Grand Fir bears S35°30'E, a distance of 27.6 feet to center with face mkd. T5NR37E1/4S`BT."

A 6.0 ft. studded "T" steel fence post driven 1.5 feet into the ground bears North, a distance of 10 feet.

I affixed Umatilla County Surveyor Yellow Metal Bearing Object signs to the new bearing trees. I also affixed Yellow Metal Bearing Tree signs (penalty for disturbance, etc.) to each new tree. Bearings are magnetic using a "Silva Ranger" compass, with a declination of 19°E, calibrated to true bearing by solar observation.

Surveyor Paul W.P. Tomkins noted in his October 15, 1999 survey, shown on Umatilla County Survey record of surveys 99-258-C, "Found S ¼ Corner S. 36 per Survey 92-106-C and Land Corner Record."

Surveyor Paul W.P. Tomkins noted in his August 13, 2001 survey, shown on Umatilla County Survey record of surveys 01-132-C, "Found 1" Pipe with Brass Cap established by Survey 92-106-C. South ¼ Corner Section 36."

**MOUNUMENT AND ACCESSORIES FOUND:**

2½" Brass Cap on 2" pipe at ground level with a "T: post 1.00 feet north.

A 26 inch in diameter White Fir with healed blaze and bearing tag, bears N36°E, 30.70 Feet.

A 28 inch in diameter White Fir with blaze and bearing tag, bears S72°E, 39.20 Feet.

A 24 inch in diameter White Fire with blaze and bearing tag, bears S36°E, 27.60 Feet.

An 18 inch in diameter Spruce with healed blaze and bearing tag, bears N42°W, 18.20 Feet.

**MOUNUMENT MARKING DETAIL:**

T 6 N R 37 E  
S 36  
S 1 ¼  
T 5 N R 37 E  
2014  
LS 02820

**MOUNUMENT AND ACCESSORIES SET:**

At found monument location set a 2½" brass cap on a 1½" x 30" galvanized iron pipe flush with the ground.

No new accessories were established.

**LOCATION AND COMMENTS:**

Bearings taken with Silva hand compass and distances measured with a steel tape.

**OREGON STATE PLANE COORDINATE, North Zone, NAD 83(91), International Feet:**

N = 840845.13

E = 8803955.85


**COMPASS DECLINATION:** 15° East

**SURVEYORS' SEAL:**

**FIRM:** HDJ Design Group  
5 N. Colville, Suite 200  
Walla Walla WA 99362

**WITNESSES:** Thomas J. Boshart  
Felipe G. Hernandez

REGISTERED  
PROFESSIONAL  
LAND SURVEYOR

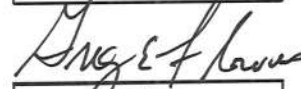

OREGON  
JUNE 30, 1997  
GREG E. FLOWERS  
02820LS

RENEWS 12/31/15

6/29/2015