

HISTORY OF ORIGINAL CORNER ESTABLISHMENT:

This record has been prepared to provide current information regarding the condition of the corner monument and accessories as described in the survey records cited below. Verification of the position of the corner monument and dimensions to existing accessories, and the establishment of new corner accessories was not performed as part of this visit.

The source of the monumentation and dimensions cited in this record is a Dependent Resurvey of ... Portions of the South and East Boundary, and Subdivisional Lines of Township 6 North, Range 38 East, Willamette Meridian, conducted by the Bureau of Land Management, commenced on October 13, 1987, and completed September 16, 1991.

RECORD DESCRIPTION OF CORNER MONUMENT AND ACCESSORIES:

From the BLM Dependent Resurvey:

The closing corner of Tps. 5N, Rng. 38 and 39E, monumented with an iron post, 3 ins. diam., firmly set, protruding 8 ins. above the ground, with brass cap mkd. (See diagram below), from which the remains of bearing trees mkd. by Gould :

A fir, 14 ins. diam., bears S7°E 45 ½ lks. dist., with scribe marks T6N BT visible on partially healed and rotted blaze, (Record S5°E 45 lks.),

A rotted fir stump, 7 ins. diam., bears S7 ¼°W 40 lks. dist., with axe marks (Record S9°W), and a new bearing tree:

A fir, 14 ins. diam., bears S63°W 65 ½ lks. dist., mkd. T5N R38E S1 CC BT

DESCRIPTION OF MONUMENT AND ACCESSORIES FOUND AT THIS CORNER LOCATION:

Found:

A 3 ½" dia. Brass cap, marked as shown, on a 3" dia. Iron pipe, extending 12" above ground, from which:

A fir, size indeterminate, dead and down, with illegible scribing visible on rotted face (Gould SE bearing tree),

The Gould SW bearing tree, described as a rotted fir stump in 1991, was not found,

A 14" Engelmann Spruce, dead and broken approx. 3' above ground, with unreadable scribing visible on a partially healed blaze (BLM 1991 SW bearing tree),

Additionally, we find the following corner accessories, for which we find no information in the Umatilla County, Oregon survey records, regarding their history:



A 16" Larch, alive and in good condition, with scribing "R38E S36 BT" and brass washer mkd. "OR2360 WA 25893" visible on a partially healed single blaze (NE quadrant),

And a 14" Larch, alive and in good condition with scribing "S6 T5N R39E BT" and brass washer as described above visible on a partially healed single blaze (SE quadrant)

Corner is located on a gentle S-SE slope.

I hereby certify that the above corner position was visited and found as described on October 17, 2005.

Witnesses: Tim Johnson, Gary Langlitz, Jeremy Jones

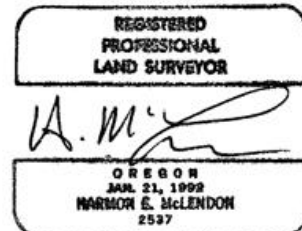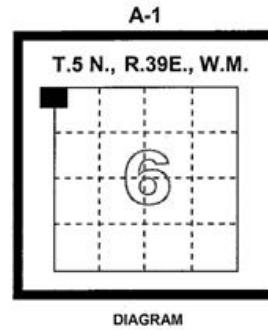

Renews 12/31/06

RECEIVED BY
Umatilla County Surveyor

Date: 1-06
Scried by: KK
No. 06-06-R