

USDA-FOREST SERVICE

CORNER RECORD (SEARCH)

(Ref. FSM 7151.4)

Index File No. E-7


Tract or Survey No. _____ Cor. No. _____

T 5N R. 38E R.D. W2 County Umatilla

Merid. Will N.F. UMATILLA State OREGON

CORNER DIAGRAM

DESCRIBE CORNER MONUMENT FOUND

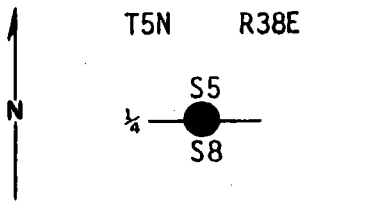

DESCRIBE BEARING TREES OR OTHER OFFICIAL ACCESSORIES FOUND

Description of corner evidence found: Remains of original SW bearing tree, now a 36" Doug. Fir stump with a notch cut on top of the stump at the correct original dia to a possible old face, no markings found. This stump is badly rotted. We open further and find no additional evidence. Note: The letters "BT" had been scribed on top of the cut area of the stump.

Ident. By _____
Signature _____ 7

PLANE COORDINATE POSITION DATA

State _____ Zone _____
X _____
Y _____
Estab. By _____
Agency _____ 8

Signature 5/ HOWARD L. PERRY Title _____ Division PLS 1294 Headquarters _____ Date 10/80 7100-52 (3, 68) 4 5

CORNER RECORD (PERPETUATION)

Description of monument and accessories established to perpetuate the

original location of this corner: Set a 1"x30" galvanized pipe with a 3" brass cap stamped:

Set pipe 20" in ground with mound of stone to cap.


Bearing trees:

A White Fir 4" dia bears S59°E 25.4 ft bark scribed ¼ S8 blaze scribed

BT.

A White Fir 12" dia bears N50°E 60.7 ft scribed ¼ S5 BT.

Attached 54-3 & 54-4 signs to both BT's. Attached brass washers stamped LS 1294 to foot blaze of both BT's. Painted blazes and 6" band around both BT's red.

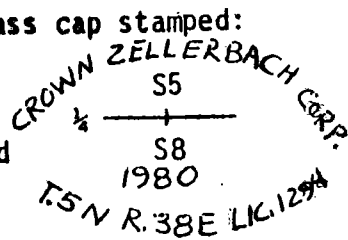

Work Done By _____ Title _____ Date _____ State Registration No. _____
 or Agency _____
 Certified Cor. Record Prepared? Yes No Filed At: _____ Date _____ 11

REMARKS

Index File No.	T.	R.	M.	Tract or Survey No.	Cor.	12
E-7	5N	38E				13

E-7

 $\frac{1}{4} \frac{5}{8}$ TSN R38E

ORIG. SURVEY BY WILLIAMS, 1872

FD: POSSIBLE REMAINS OF THE ORIG SW BEARING TREE, AN ORIG 15" FIR, NOW A 36" D FIR STUMP WITH A NOTCH CUT ON TOP OF THE STUMP AT THE CORRECT ORIG DIAMETER TO A POSSIBLE OLD FACE, NO MARKINGS FOUND. THIS STUMP IS BADLY ROTTED, WE OPEN FURTHER AND FIND NO ADDITIONAL EVIDENCE. NOTE THE LETTERS "BT" HAD BEEN SCRIBED ON TOP OF THE CUT AREA OF THIS STUMP.

WE FIND A ~~LARGE~~ ROOT HOLE AND WELL DECAYED REMAINS OF A TREE AT THE APPROX. POSITION OF THE ORIG NW BEARING TREE, A 10" TAMARACK.

A WALLA WALLA MILLS LOCATION POSTER IS NEARBY.

(OVER)

LAST
PAGE
FILE

T
NO
COR

← N →

PHO
PHO
FILE
OBJ
IDEN

PLAN
Sta
X
Y
Elev

THIS CORNER LOCATION APPEARS TO BE VALID
BUT SHOULD BE EVALUATED FURTHER FOR
ITS RELATIONSHIP TO ADJOINING CORNER.

5-23-80

Larry L. Langley O.R.L.S. 1099
GREG ORTON

COMPASS DECL. 19 $\frac{1}{2}$ ° EAST

WE FIND THE DISTANCE TO THE CORNER WEST OF THE
CORNER TO BE APPROX. 100 FT. SHORTER THAN
RECORD.