

USDA-FOREST SERVICE

Index File No. H-7

CORNER RECORD (SEARCH)

(Ref. FSM 7151.4)

Tract or Survey No. \_\_\_\_\_ Cor. No. \_\_\_\_\_

T 5N R. 38E


R.D. W<sup>2</sup> County UMATILLA

Merid. WILL

N.F. UMATILLA State OREGON

CORNER DIAGRAM

DESCRIBE CORNER MONUMENT FOUND

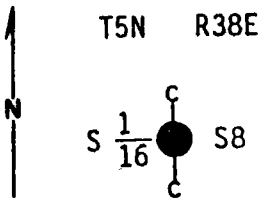

DESCRIBE BEARING TREES OR OTHER OFFICIAL ACCESSORIES FOUND

PHOTO IDENTIFICATION DATA

Photo No. \_\_\_\_\_

Filed At. \_\_\_\_\_

Object Ident. \_\_\_\_\_

Ident. By \_\_\_\_\_

*Signature*

PLANE COORDINATE POSITION DATA

State \_\_\_\_\_ Zone \_\_\_\_\_

X \_\_\_\_\_

Y \_\_\_\_\_

Estab. By \_\_\_\_\_

*Agency*

DESCRIBE CORNER LOCATION RELATIVE TO NEAR-BY FEATURES, ALSO HOW TO REACH CORNER

Signature

Title

Division

Headquarters

Date

7100-52 (3.69)

S/ HOWARD L. PERRY

PLS 1294

9/80

**CORNER RECORD (PERPETUATION)**

Description of monument and accessories established to perpetuate the original location of this corner:

At surveyed point set 1"x30" Galvanized Pipe with 3" brass cap stamped:


Set cap 24" in ground with mound of dirt to cap.

From which:

A Spruce 9" dia. bears S85°W 18.1 ft., scribed CS 1/16 S8 BT.

A Tamarack 7" dia. bears S48°E 48.6 ft., scribed CS 1/16 S8 BT.

Attached 54-3 and 54-4 signs to both BTs. Attached brass washers stamped LS 1294 to foot blaze of both BTs. Painted blazes and 6" band around both BTs red.

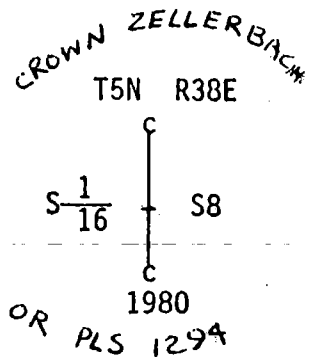

Certified Cor. Record Prepared?  Yes  No Filed At:

Date

REMARKS

Index File No.

T.

R.

M.

Tract or City No.

Cor.

H-7

5N

38E