

USDA-FOREST SERVICE

Index

File No.

T 5

CORNER RECORD (SEARCH)

(Ref. FSM 7151.4)

Tract or

Survey No.

Cor.

No.

T 5N

R. 38E

R.D. WALLA WALLA

County

UMATILLA

Merid.

WILL

N.F.


UMATILLA

State

OREGON

CORNER DIAGRAM

T5N R38E

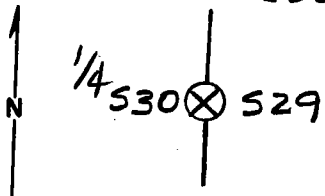

DESCRIBE CORNER MONUMENT FOUND

STONE, 18" x 8" x 4", 6" ABOVE GROUND MARKED "1/4" ON WEST FACE.

DESCRIBE BEARING TREES OR OTHER OFFICIAL ACCESSORIES FOUND

8" FIR IS DOWN & DEAD, BEARS N83°E, 34.5ft.
24" FIR BEARS N76°W, 24ft.
PAINTED & SIGNED THE 24" FIR

PHOTO IDENTIFICATION DATA

Photo No.

Filed At.

Object Ident.

Ident. By

Signature

PLANE COORDINATE POSITION DATA

State _____ Zone _____

X _____

Y _____

Estab. By _____

Agency

Signature

Title

Division

Headquarters

Date

7100-52-(3/68)

15/ R.M. - R.H. - D.H.

FORESTERS

B.C.C.

7-14-80

CORNER RECORD (PERPETUATION)

MONUMENT: DESCRIBE NEW MONUMENT SET, OR WORK DONE TO PRESERVE EXISTING MONUMENT

ACCESSORIES : DESCRIBE NEW BT'S WITNESS OBJECTS ETC. ESTABLISHED, OR WORK DONE TO PRESERVE EXISTING EVIDENCE

Work Done By _____ Title _____ Date _____ State Registration No. or Agency _____
Certified Cor. Record Prepared ? Yes No Filed At: _____ Date _____

REMARKS

Index File No. T. R. M. Tract or Surv. No. Cor.