

USDA-FOREST SERVICE


Index
File No. Z-7
T 5N R. 39E
Merid. Will

CORNER RECORD (SEARCH)

(Ref. FSM 7151.4)

Tract or Survey No. _____ Cor. No. _____
R.D. WALLA WALLA County UNION/WALLOWA
N.F. UMATILLA State OREGON

CORNER DIAGRAM

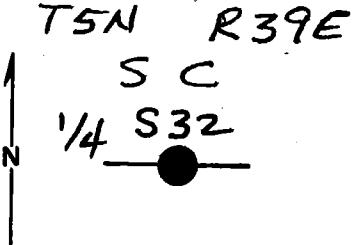

DESCRIBE CORNER MONUMENT FOUND

FOUND 1932 BRASS CAP IN GOOD
CONDITION

DESCRIBE BEARING TREES OR OTHER OFFICIAL ACCESSORIES FOUND

ORIG. 10" PINE IS LIVE WITH FRAGMENTARY SCRIBES
VISIBLE ON A SINGLE BLAZE. THIS IS A L.P.P. & BEARS
N62°E, 180.8 FT.
ORIG. 7" PINE IS A LIVE L.P.P. WITH SCRIBES VISIBLE
ON A SINGLE BLAZE. BEARS N55°W, 86.5 FT.

DESCRIBE CORNER LOCATION RELATIVE TO NEAR-BY FEATURES, ALSO HOW TO REACH CORNER

CORNER IS 350 FT. EAST OF "K" TAG ON
KENDALL SKYLINE ROAD.

PHOTO IDENTIFICATION DATA

Photo No. _____
Filed At. _____
Object Ident. _____
Ident. By _____
Signature

PLANE COORDINATE POSITION DATA

State _____ Zone _____
X _____
Y _____
Estab. By _____
Agency

Signature Dennis L. Hayward *Title* _____ *Division* PLS 1636 *Headquarters* S.O. *Date* 6-12-85 ES-7100-52 (3/68)

CORNER RECORD (PERPETUATION)

MONUMENT: DESCRIBE NEW MONUMENT SET, OR WORK DONE TO PRESERVE EXISTING MONUMENT

9

ACCESSORIES : DESCRIBE NEW BT'S WITNESS OBJECTS ETC. ESTABLISHED, OR WORK DONE TO PRESERVE EXISTING EVIDENCE

10

Work Done By _____ Title _____ Date _____ State Registration No.
or Agency _____

Certified Cor. Record Prepared ? Yes No Filed At: _____ Date _____ 11

REMARKS

12

Index File No. T. R. M. Tract or Surv. No. Cor. 13