

Index File No. T-25


CORNER RECORD (SEARCH) Tract or Survey No.

Cor. No. T-25 ²⁷ ⁹

T 5S R. 29E
Merid. Willamette

R.D. Ukiah County Morrow
N.F. Umatilla State Oregon

CORNER DIAGRAM

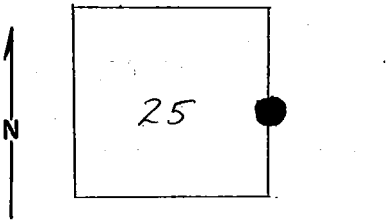

~~DESCRIBE CORNER MONUMENT FOUND~~ *Original notes*
BT PP (fallen over) S60E 34'
DF 25" dia. BH N44W 77'

Monumented by BLM in 1978

DESCRIBE BEARING TREES OR OTHER OFFICIAL ACCESSORIES FOUND
a sec. line board on the road between Divide Well and Matlock Water Hole, thus north 650' to a pile of rock that indicated the corner.

PHOTO IDENTIFICATION DATA

Photo No. _____
Filed At. _____
Object Ident. _____
Ident. By _____
Signature

DESCRIBE CORNER LOCATION RELATIVE TO NEAR-BY FEATURES, ALSO HOW TO REACH CORNER

PLANE COORDINATE POSITION DATA

State _____ Zone _____
X _____
Y _____
Estab. By _____
Agency

Signature L. Waid Title _____ Division _____ Headquarters _____ Date 1962

CORNER RECORD (PERPETUATION)

MONUMENT: DESCRIBE NEW MONUMENT SET, OR WORK DONE TO PRESERVE EXISTING MONUMENT

9

ACCESSORIES DESCRIBE NEW BT's WITNESS OBJECTS ETC. ESTABLISHED, OR WORK DONE TO PRESERVE EXISTING EVIDENCE

10

Work Done By _____ Title _____ Date _____ State Registration No. or Agency _____

Certified Cor. Record Prepared ? Yes No Filed At: _____ Date _____

11

REMARKS

12

Index File No. T-25 T. R. M. Tract or Surv. No. Cor. 13