

USDA-FOREST SERVICE

Index
File No. Z-21

CORNER RECORD (SEARCH)

(Ref. FSM 7151.4)

Tract or Survey No. _____ Cor. RM No. Sec Cor


T 5S R. 29E

R.D. Ukiah County Morrow

Merid. Willamette

N.F. Umatilla State Oregon

CORNER DIAGRAM

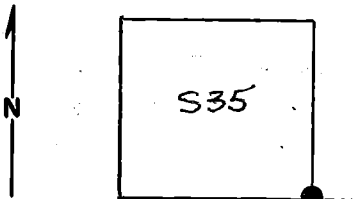

DESCRIBE CORNER MONUMENT FOUND

None

DESCRIBE BEARING TREES OR OTHER OFFICIAL ACCESSORIES FOUND

None

PHOTO IDENTIFICATION DATA

Photo No. _____
Filed At. _____
Object Ident. _____
Ident. By _____
Signature

DESCRIBE CORNER LOCATION RELATIVE TO NEAR-BY FEATURES, ALSO HOW TO REACH CORNER

Corner lies in Road along Std. parallel
RM just North of said Road and visible from same.

PLANE COORDINATE POSITION DATA

State _____ Zone _____
X _____
Y _____
Estab. By *[Signature]* Agency _____

Signature

Title

FLS
Division

346
Headquarters

9/79
Date

7100-52-(3/68)

CORNER RECORD (PERPETUATION)

MONUMENT: DESCRIBE NEW MONUMENT SET, OR WORK DONE TO PRESERVE EXISTING MONUMENT

Drove 7" RR spike at Corner Pt. (unable to set iron pipe below Road surface.)

ACCESSORIES : DESCRIBE NEW BT's WITNESS OBJECTS ETC. ESTABLISHED, OR WORK DONE TO PRESERVE EXISTING EVIDENCE

Set 32" X 2" flanged iron pipe with brass cap marked
BRS. N45°W., 10.0 Ft. Distance.

T5S R29E

S35 SC

RM

1979 ~~40~~

PLS 346

Douglas Fir, 10" Dia., BRS. N14 $\frac{1}{2}$ °W., 24.4 Ft. Distance.

Ponderosa Pine, 8" Dia., BRS. N32 $\frac{1}{2}$ °E., 46.6 Ft. Distance.

6' Iron Fence Post with "Survey Monumetrn" sign within 5' of Corner.

10

Work Done By Wayne O. Harris Title PLS Date 9/79 State Registration No. or Agency 346

Certified Cor. Record Prepared ? YES NO XXX Filed At: Morrow Co. Surveyor Office Date _____

11

REMARKS

12